

November 21, 2022

Ms. Lori Capone
Conservation Coordinator
275 Old Lancaster Road
Sudbury, Massachusetts 01776

**Re: Response to Second Review of Nobscot Scout Reservation Trail Project
1 Nobscot Road, Sudbury, MA**

Dear Ms. Capone:

Howard Stein Hudson (HSH) has prepared a response to the Sudbury Conservation Commission comments dated November 2, 2022 and offers the following responses including submitting supplemental information:

Comment 1: *Invasive Species Management Plan, for areas disturbed by this violation until reestablished, and additional invasive species management to mitigate for this violation, should be included in this application. The recent submittal states that the applicant will manage invasive species within 5 feet of the limit of disturbance. They are also willing to attend SVT's Weed Warrior program to learn about invasive species so that scout volunteers can identify and remove invasives throughout the trail system. At a minimum, the project should be conditioned that the applicant develop a management plan to manage invasives in a similar square footage to the area of unpermitted disturbance, along the trail system and/or around the cabins. It was identified at the site walk that porcelain berry is present around at least one of the cabins which is a newer invasive species. This species should be a main target, as should bittersweet as these species can greatly impact the forest habitat.*

Response: **The applicant is committed to having two invasive mitigation plans. The first plan is to have Lucas Environmental perform invasive monitoring and removal within the work zones and up to 15ft outside these zones. If there is a particular bad area of invasives adjacent to a work zone that extends past 15ft Lucas will monitor it and remove it.**

The second plan the applicant has committed to is to have the volunteers complete a Weed Warrier program, and in coordination with Lucas Environmental, HSH, and the Sudbury Conservation Commission Agent



prepare an invasive management plan for the Reservation, which would identify larger areas with invasives within the Trail system, to be monitored and removed by the volunteer group.

Comment 2: *It is unclear how the volunteers will know how to grade the trail. This is concerning as the work that was conducted was directing runoff directly to the wetlands. I recommend work within jurisdictional areas, and areas that discharge towards jurisdictional areas, be overseen by a professional engineer and wetland scientist to direct this activity. I feel this is particularly critical for the work to restore the steep section of the Monson Trail.*

Response: **All of the restoration work, trail improvements, swale construction, wall installation and grading will be overseen by the Project Engineer. The work can be staked out in the field by a professional surveyor if needed.**

Comment 3: *Three trees are noted to be removed along this steep section. Information should be provided as to why they are proposed to be removed. Six trees are shown on the plan to be removed on Sheet 9 but not noted in the trail improvements table. Two additional trees are noted in the table on the Legion Trail but I do not see where they are on the plan or why they are proposed to be removed. The applicant should provide clarification.*

Response: **The plans have been revised to note two trees along this steep section of trail to be removed due to their poor condition and exposed roots. The third tree will remain.**

The location of the six trees to be removed on Sheet 9 have been revised to reflect their location more accurately. Table 4-1 of the NOI has been revised to include these trees in the Segment 4 Trail Improvements and added to the total number of trees to be removed, which is now 8.

The two additional trees to be removed on the Legion Trail was an error and have been eliminated from the trail improvements table.

Comment 4: *The wetland impacted by silt is noted to be removed by hand following erosion control installation however no information is provided as to how this will be accomplished and no erosion controls are shown around this work area. Additionally, no wetland impacts, temporary or permanent, are noted in the chart on this plan sheet (Sheet 5). The applicant should clarify.*



Response: The plans have been revised to include this area in the temporary wetland impacts noted in the plan table on Sheet 5 and in the calculated totals of the NOI. Erosion control barriers are shown up-hill of the affected wetland.

Comment 5: A large section of boulders that were stabilizing the hillside were removed. The plan has been revised to use some of these rocks to build a 45-foot section of wall. The rest of the disturbed embankment is proposed to be regraded and hydroseeded. If the boulders are not being replaced, then the areas that are being regraded should be planted with shrubs, in addition to hydroseeding, to stabilize this slope. Blueberry sod could also be looked at as a means to stabilize this area.

Response: The intend is to restore the disturbed areas with a Forestry seed mix. This mix shall be submitted to the Commission Agent for review.

Comment 6: Stumps that were proposed to be removed in front of the Legion Cabin were viewed in the field and found not to be necessary and could lead to additional erosion and invasive species introduction. The plan has been revised to no longer show these stumps being removed but the narrative states that stumps will be cut as close to the ground and ground in place and wood chips used to stabilize the ground around this cabin. The applicant should clarify which stumps they are referring to. These stumps are outside wetlands jurisdiction but within the Conservation Restriction held by the Town and SVT.

Response: The stumps are to be cut close to the ground and stumped in place refer to areas shown around cabin 14 on sheet 16 of the NOI Plans.

Comment 7: Less intrusive footings for the boardwalks were discussed at the site walk. For the replacement and new boardwalks, since the last time this was in front of the Commission, the scouts had asked to install cedar stringers for the two bog boardwalks with direct ground contact, no footings are necessary. The 6-inch buried concrete footings proposed on the other bridge were requested to be replaced with 12-inch concrete blocks that sit on the ground and do not require excavation. The revised plans do not indicate any change to the original footings. The applicant should clarify.

Response: As discussed in the field the bridge footings to be installed as designed using precast concrete.

Comment 8: At the new culvert that is proposed, a restoration detail and construction narrative should be provided to direct restoration efforts. The Order should be conditions to require wetland alteration and restoration work to be conducted under direct



supervision of a wetland scientist. Invasive species management is needed in this area. Additional wetland replication is now shown in this area in two locations. The applicant should explain why two locations, versus one, is beneficial and why it is not advisable to combine this wetland replication with the original area of wetland replication. These replications areas result in additional alterations to upland areas and also move the wetlands closer to the adjacent latrine.

Response: **As discussed in the field, rather than replicate wetland in this area a more robust invasive removal program will be put in place.**

Comment 9: *The latrine in the area of this culvert is in failure. The scouts have implied that the wetland is clogged with trees and vegetation which is causing water to flow into the latrine. They also want to install a rubber membrane between the wetland and latrine to prevent water from entering. This was not evident upon inspection and given the drought conditions, it is unlikely that the wetland is impacting the functionality of this latrine, which is completely full. The Board of Health has directed the applicant to have this latrine pumped, which was a requirement when it was installed. The applicant should provide an update on this element.*

Response: **There is no clear evidence of a leak in the latrine holding tank. The applicant is coordinating having the tank pumped, after which an inspection of the tank will be completed with a certified Title V inspector. Any proposed improvement associated with the tank will be coordinated and submitted to the Conservation Commission for review and approval.**

Comment 10: *Areas of crushed stone within wetlands that were called out as temporary impacts should be considered permanent alterations and will need to be quantified and included in the proposed wetlands replication area. The applicant states that any fill being introduced less than 12 inches in depth is not being considered an impact to wetlands. The applicant should clarify.*

Based on Monday's discussion, I know the Commission did not give you direction on this, but I think it is reasonable to count adding additional stone to areas that already have stone as a temporary impact and new areas of stone and/or fill as a permanent alteration.

Response: **Based on our site walk it was discussed that the stone being added to the nature trail was a temporary alteration.**



Comment 11: *The applicant is looking to now loam and seed the area adjacent to the new bog bridges, further altering wetlands. If this work is done by hand, there should not be any need to loam and seed and should not be permitted.*

Response: **The plans have been revised to show silt fencing staked in place at the trail's edge to eliminate the impact on adjacent wetlands and the need for any additional loam & seed in these areas.**

Comment 12: *The applicant should clarify silt fence installation around the cabins, such as shown on sheet 18 for Cabin 8. This is located very close to wetlands and there is no way to access the excavation area whereas it is completely surrounded by silt fence. There is also no access shown to this cabin nor protection of the wetland located between the trail and the cabin.*

Response: **The enclosed silt fence around the cabin is to create a work zone to provide a continuous barrier to keep turtles from entering. A section of fence will be removed to allow access. An additional line of silt fence has been added between the wetland and the work zone. The access trail to the cabin 8 have also been added.**

Please contact me at (617) 348-3310 or jdowning@hshassoc.com if you have any additional questions or comments.

Sincerely,

James Downing
Project Manager

cc: MassDEP Division of Wetlands & Waterways, Northeast Regional Office
Massachusetts Natural Heritage & Endangered Species Program (electronic copy)
Lucas Environmental, LLC (electronic copy)
Property Owner &Applicant – Mayflower Council, Boy Scouts of America (electronic copy)

Attachments; Updated NOI Plans, impact tables.

TABLE 4-1
SUMMARY OF TRAIL IMPROVEMENTS

Station Range	Trail Names	Length (feet)	Proposed Trail Base	# of Trees to be Removed
Segment 1 – Town of Sudbury				
98+20 - 103+20	Thirty Rod Road	500	6" gravel/crushed stone	0
108+70 - 110+20	Thirty Rod Road	150	6" gravel/crushed stone	0
110+90 - 111+40	Thirty Rod Road	50	6" gravel/crushed stone	0
112+00 - 112+20	Gen John Nixon Trail	20	6" gravel/crushed stone	0
113+10 - 113+50	Gen John Nixon Trail	40	6" gravel/crushed stone	0
114+05 - 114+70	Gen John Nixon Trail	65	6" gravel/crushed stone	0
0+85 - 2+35	Gen John Nixon Trail	150	6" gravel/crushed stone	0
120+60 - 124+20	White Ridge Trail	360	6" gravel/crushed stone	2
124+45 - 125+00	White Ridge Trail	55	6" gravel/crushed stone	0
126+00 - 126+50	White Ridge Trail	50	6" gravel/crushed stone	0
Subtotal Segment 1		1,440	---	2
Segment 2 – City of Framingham				
127+80 - 128+80	White Ridge Trail	100	6" gravel/crushed stone	0
131+20 - 131+60	Jethro Trail	40	6" gravel/crushed stone	0
133+55 - 133+70	Jethro Trail	15	6" gravel/crushed stone	0
135+50 - 135+90	Jethro Trail	40	6" gravel/crushed stone	0
140+90 - 141+30	Jethro Trail	40	6" gravel/crushed stone	0
142+90 - 145+50	Jethro Trail	260	6" gravel/crushed stone	0
147+60 - 147+90	Jethro Trail	30	6" gravel/crushed stone	0
148+40 - 149+00	Jethro Trail	60	6" gravel/crushed stone	0
153+20 - 155+30	Jethro Trail	210	6" gravel/crushed stone	0
162+20 - 163+00	Ellis Land Trail	80	6" gravel/crushed stone	0
164+00 - 166+50	Ellis Land Trail	250	6" gravel/crushed stone	0
169+00 - 171+90	Ellis Land Trail	290	6" gravel/crushed stone	0
Subtotal Segment 2		1,415	---	0
Segment 3 – Town of Sudbury & City of Framingham				
400+17 - 404+57	Monson Trail	460	6" gravel/crushed stone	0
405+60 - 406+25	Monson Trail	65	6" gravel/crushed stone	0
408+70 - 412+50	Monson Trail	380	6" gravel/crushed stone	0
414+65 - 414+00	Monson Trail	35	6" gravel/crushed stone	0
416+13 - 416+38	Monson Trail	25	6" gravel/crushed stone	0
417+40 - 419+05	Monson Trail	165	6" gravel/crushed stone	0
Subtotal Segment 3		1,130	---	0
Segment 4 – Town of Sudbury				
--	Main Gate Drive	--	N/A	6
1+38 - 1+46	Legion Trail	8	6" gravel/crushed stone w/ filter fabric base	0
4+86 - 4+98	Legion Trail	12	6" gravel/crushed stone w/ filter fabric base	0
7+53 - 7+78	Nipmuc Trail	25	6" gravel/crushed stone	0

TABLE 4-1
SUMMARY OF TRAIL IMPROVEMENTS

Station Range	Trail Names	Length (feet)	Proposed Trail Base	# of Trees to be Removed
8+68 - 9+33	Legion Trail	65	6" gravel/crushed stone	0
9+91 - 10+39	Legion Trail	48	6" gravel/crushed stone	0
Subtotal Segment 4		158	---	6
Segment 5 – Town of Sudbury				
200+50 - 201+00	Gen John Nixon Trail	50	6" gravel/crushed stone	0
202+40 - 203+60	Gen John Nixon Trail	120	6" gravel/crushed stone	0
204+50 - 205+40	Gen John Nixon Trail	90	6" gravel/crushed stone	0
207+00 - 207+40	Gen John Nixon Trail	40	6" gravel/crushed stone	0
207+90 - 208+20	Gen John Nixon Trail	30	6" gravel/crushed stone	0
210+50 - 211+50	Gen John Nixon Trail	100	6" gravel/crushed stone	0
214+00 - 217+70	Gen John Nixon Trail	370	6" gravel/crushed stone	0
220+30 - 223+80	Gen John Nixon Trail	350	6" gravel/crushed stone	0
226+50 - 227+70	Gen John Nixon Trail	120	6" gravel/crushed stone	0
300+00 - 310+10	Ghost Trail	110	6" gravel/crushed stone	0
301+60 - 304+00	Ghost Trail	240	6" gravel/crushed stone	0
310+10 - 311+50	Ghost Trail	140	6" gravel/crushed stone	0
315+25 - 315+75	Nipmuc Trail	50	6" gravel/crushed stone	0
318+25 - 319+65	Nipmuc Trail	140	6" gravel/crushed stone	0
Subtotal Segment 5		1,950	---	0
PROJECT TOTAL		6,093		8

TABLE 5-1
SUMMARY OF PROPOSED BANK IMPACTS*

Resource Area	Temporary Impacts	Permanent Impacts	Total Impacts	Proposed Mitigation
Inland Bank				
Sudbury	28 LF	10 LF	38 LF	28± LF Restored in Place
Framingham	161 LF	0 LF	161 LF	161 LF Restored in Place
Total	189 LF	10 LF	199 LF	

*Impact calculations provided by Howard Stein Hudson.

TABLE 5-2
SUMMARY OF PROPOSED WETLAND IMPACTS*

Resource Area	Temporary Impacts	Permanent Impacts	Total Impacts	Proposed Mitigation
Bordering Vegetated Wetland				
Sudbury	2,980 SF	253 SF	1,128 SF	150 SF Replication Area in Sudbury (2:1); Invasives Mitigation/Monitoring; 2,980 SF Restored In Place
Framingham	229 SF	0 SF	229 SF	229 SF Restored In Place
Total	3,209 SF	253 SF	1,357 SF	

*Impact calculations provided by Howard Stein Hudson.

TABLE 5-3
IMPACT ANALYSIS

Phase	Trail	Proposed Impact Area (SF)					
		Sudbury		Framingham		Total	
		Turtle Habitat	Non-Turtle Habitat	Turtle Habitat	Non-Turtle Habitat	Non-Turtle Habitat	Turtle Habitat
I	Monson	0	4,819	1,248	4,538	9,357	1248
	Gen John Nixon	11,051	13,088	0	0	13,088	11,051
	Ellis Land	0	0	1,418	5,813	5813	1418
	White Ridge	2,387	3,126	409	1,400	4,526	2,796
II	Sisson	2,373	1,850	0	0	1,850	2,673
	Thirty Rod Road	1,244	7,928	0	0	7,928	1,244
	Jethro	0	0	2,730	5,274	5,274	2,730
III	Ghost	0	2,604	0	0	2,604	0
	Nipmuc	316	2,341	0	0	2,341	316
	Big/Little Sachem Bridges	56	229	0	0	229	56
IV	Belden Bridge	36	125	0	0	125	36
Subtotal (SF)		17,463	36,110	5,805	17,025	53,135	23,568
Subtotal (Acres)		0.40	0.83	0.13	0.39	1.22	0.54
TOTAL		53,573 (1.23 Acres)		22,830 (0.52 Acres)		76,403 (1.75 Acres)	




HOWARD STEIN HUDSON
11 Beacon Street, Suite 1010
Boston, MA 02108
www.hshassoc.com

SITE PLAN FOR NOBSCOT SCOUT RESERVATION TRAIL PROJECT SUDBURY AND FRAMINGHAM, MA.

GENERAL NOTES:

1. EXISTING PROPERTY LINE AND UTILITY INFORMATION SHOWN IS BASED ON AN EXISTING SURVEY CONDUCTED BY FELDMAN LAND SURVEYORS REVISED THROUGH 04-13-2022.
2. WETLAND DELINEATION COMPLETED BY LUCAS ENVIRONMENTAL, LLC UPDATED THROUGH MARCH 17, 2022.
3. "WF" SERIES REFER TO BORDERING VEGETATED WETLANDS, UNLESS OTHERWISE NOTED OR LABELED.
4. "BF" SERIES REFER TO INLAND BANK, UNLESS OTHERWISE NOTED OR LABELED.
5. THE 100-FOOT BUFFER ZONE IN THE TOWN OF SUDBURY IS DESIGNATED AS THE ADJACENT UPLAND RESOURCE AREA.
6. WF-J CONTAINS A CERTIFIED VERNAL POOL.
7. THE LIMIT OF WORK AREA IS LOCATED WITHIN ESTIMATED HABITAT FOR RARE WILDLIFE (EH 622) AND PRIORITY HABITAT FOR RARE SPECIES (PH 669).
8. THE ACCURACY AND COMPLETENESS OF THE UNDERGROUND UTILITIES AS SHOWN ON THE PLANS ARE NOT GUARANTEED. IT SHALL BE THE CONTRACTOR'S RESPONSIBILITY TO DETERMINE THE EXACT LOCATION, SIZE, TYPE, ETC. OF ALL UNDERGROUND UTILITIES THAT MAY BE AFFECTED BY THE WORK. AT LEAST 72 HOURS BEFORE EXCAVATION, THE CONTRACTOR SHALL BE REQUIRED TO CONTACT DIGSAFE AT 1-888-344-7233.
9. THE CONTRACTOR SHALL FIELD VERIFY CONDITIONS AND DIMENSIONS PRIOR TO CONSTRUCTION AND REPORT ANY DISCREPANCIES TO THE ENGINEER.
10. WHERE AN EXISTING UTILITY IS FOUND TO CONFLICT WITH THE PROPOSED WORK, THE LOCATION, ELEVATION, AND SIZE OF THE UTILITY SHALL BE APPROPRIATELY DETERMINED WITHOUT DELAY BY THE CONTRACTOR AND THE INFORMATION FURNISHED TO THE ENGINEER FOR RESOLUTION.
11. ALL UTILITY COMPANIES, PUBLIC AND PRIVATE, MUST BE NOTIFIED, INCLUDING THOSE IN CONTROL OF UTILITIES NOT SHOWN ON THIS PLAN, PRIOR TO EXCAVATING, BLASTING, INSTALLING, BACKFILLING, GRADING, PAVEMENT RESTORATION OR REPAVING.
12. THE CONTRACTOR SHALL MAINTAIN ALL EXISTING UTILITIES EXCEPT THOSE NOTED TO BE ABANDONED, REMOVED AND DISPOSED.
13. THE CONTRACTOR SHALL DISPOSE OF ALL WASTE MATERIAL IN ACCORDANCE WITH ALL FEDERAL, STATE, AND LOCAL REQUIREMENTS AT HIS/HER OWN EXPENSE, OUTSIDE OF THE PROJECT LIMITS.
14. THE SILT FENCE WILL BE INSTALLED AS CONSTRUCTION PROGRESSES IN AREAS SHOWN ON THE PLANS. IT WILL NOT BE INSTALLED SIMULTANEOUSLY THROUGHOUT THE SITE.
15. THE SILT FENCE IS TO BE USED AS THE TURTLE PROTECTION BARRIER IN ADDITION TO USE AS AN EROSION CONTROL DEVICE.
16. CONTRACTOR SHALL INSTALL A PLYWOOD CONSTRUCTION ACCESS BARRIER FOR TURTLE PROTECTION. THE BARRIER SHALL BE REMOVED AND REPLACED DAILY OR WHEN ACCESS IS NECESSARY.
17. GIS TOPOGRAPHIC INFORMATION PROVIDED FOR WOODED AREAS TO SUPPLEMENT THE SURVEY PROVIDED BY FELDMAN LAND SURVEYORS.

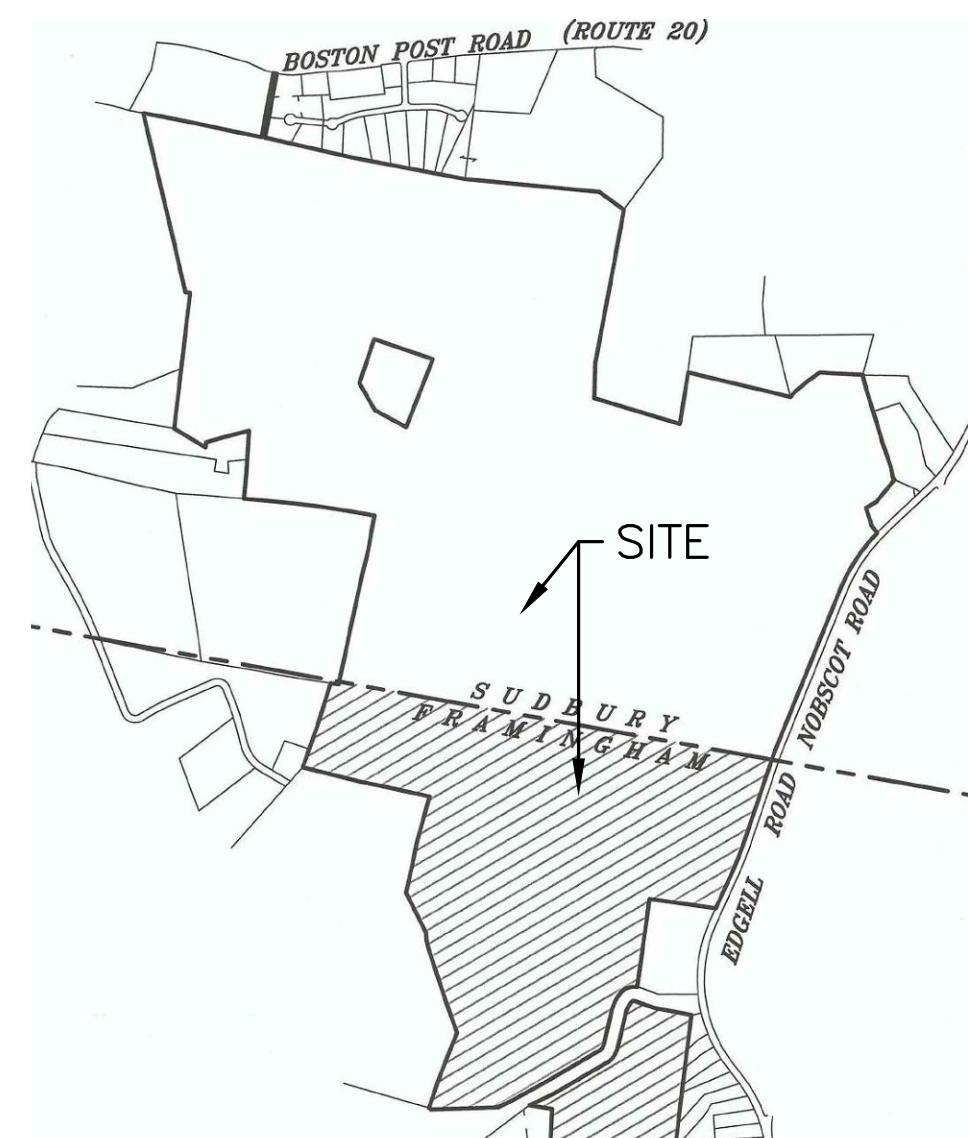

**LOCUS MAP
NOT TO SCALE**

SHEET INDEX

- | | |
|------------|----------------------------------|
| SHEET 1 | COVER SHEET |
| SHEET 2 | PARTIAL EXISTING CONDITIONS PLAN |
| SHEET 3 | KEY PLAN |
| SHEET 4-21 | CONSTRUCTION PLANS |
| SHEET 22 | DETAIL SHEET |

OWNER

BOY SCOUTS OF AMERICA
MAYFLOWER COUNCIL
83 CEDAR STREET
MILFORD, MA 01757

FRAMINGHAM ASSESSORS INFORMATION

ASSESSORS MAP 008 BLOCK 01 LOT 2517
ASSESSORS MAP 008 BLOCK 11 LOT 7059
ASSESSORS MAP 015 BLOCK 19 LOT 6802

SUDSBURY ASSESSORS INFORMATION

ASSESSORS MAP L BLOCK 05 LOT 0001
ASSESSORS MAP L BLOCK 05 LOT 0003
ASSESSORS MAP L BLOCK 05 LOT 0004
ASSESSORS MAP L BLOCK 05 LOT 0005
ASSESSORS MAP L BLOCK 05 LOT 0007
ASSESSORS MAP L BLOCK 05 LOT 0200
ASSESSORS MAP L BLOCK 06 LOT 0009

REFERENCES

1. EXISTING CONDITIONS SURVEY BY FELDMAN LAND SURVEYORS.

**NOBSCOT SCOUT
RESERVATION TRAIL
PROJECT
SUDBURY AND FRAMINGHAM, MA
WORCESTER COUNTY**

REVISIONS:			
NO	BY	DATE	DESCRIPTION
1	JC	10/24/22	REVIEW REVISIONS
2	JC	11/21/22	REVIEW REVISIONS #2

**NOBSCOT SCOUT
RESERVATION TRAIL
PROJECT
1 NOBSCOT ROAD
SUDBURY MA 01776**

**NOTICE OF INTENT
PERMIT SET**

**COVER
SHEET**



DATE:	11/21/2022
PROJECT NUMBER:	16033.02
DESIGNED BY:	JBC
DRAWN BY:	JBC
CHECKED BY:	REL



I CERTIFY THAT THIS PLAN IS BASED ON AN ACTUAL FIELD SURVEY.



10/21/22
DATE

TIMOTHY R. AGURKIS, PLS (MA# 52782)
TRA@FELDMANGEOT.COM

PARTIAL EXISTING CONDITIONS PLAN
NOBSCOT RESERVATION

**SUDBURY &
FRAMINGHAM, MASS.**


APRIL 5, 2022
PHONE: (617)357-9740
www.feldmangeospatial.com


FELDMAN
GEOSPATIAL


200 0 100 200 400 800

SCALE: 1'=200'


RESEARCH	FIELD CHIEF	PROJ MGR	APPROVED	SHEET NO. OF
CALC	CADD	FIELD CHECKED	ORD FILE	JOB NO. 2200117
FILENAME: S:\PROJECTS\2022\2200117\DWG\2200117-EC.dwg				

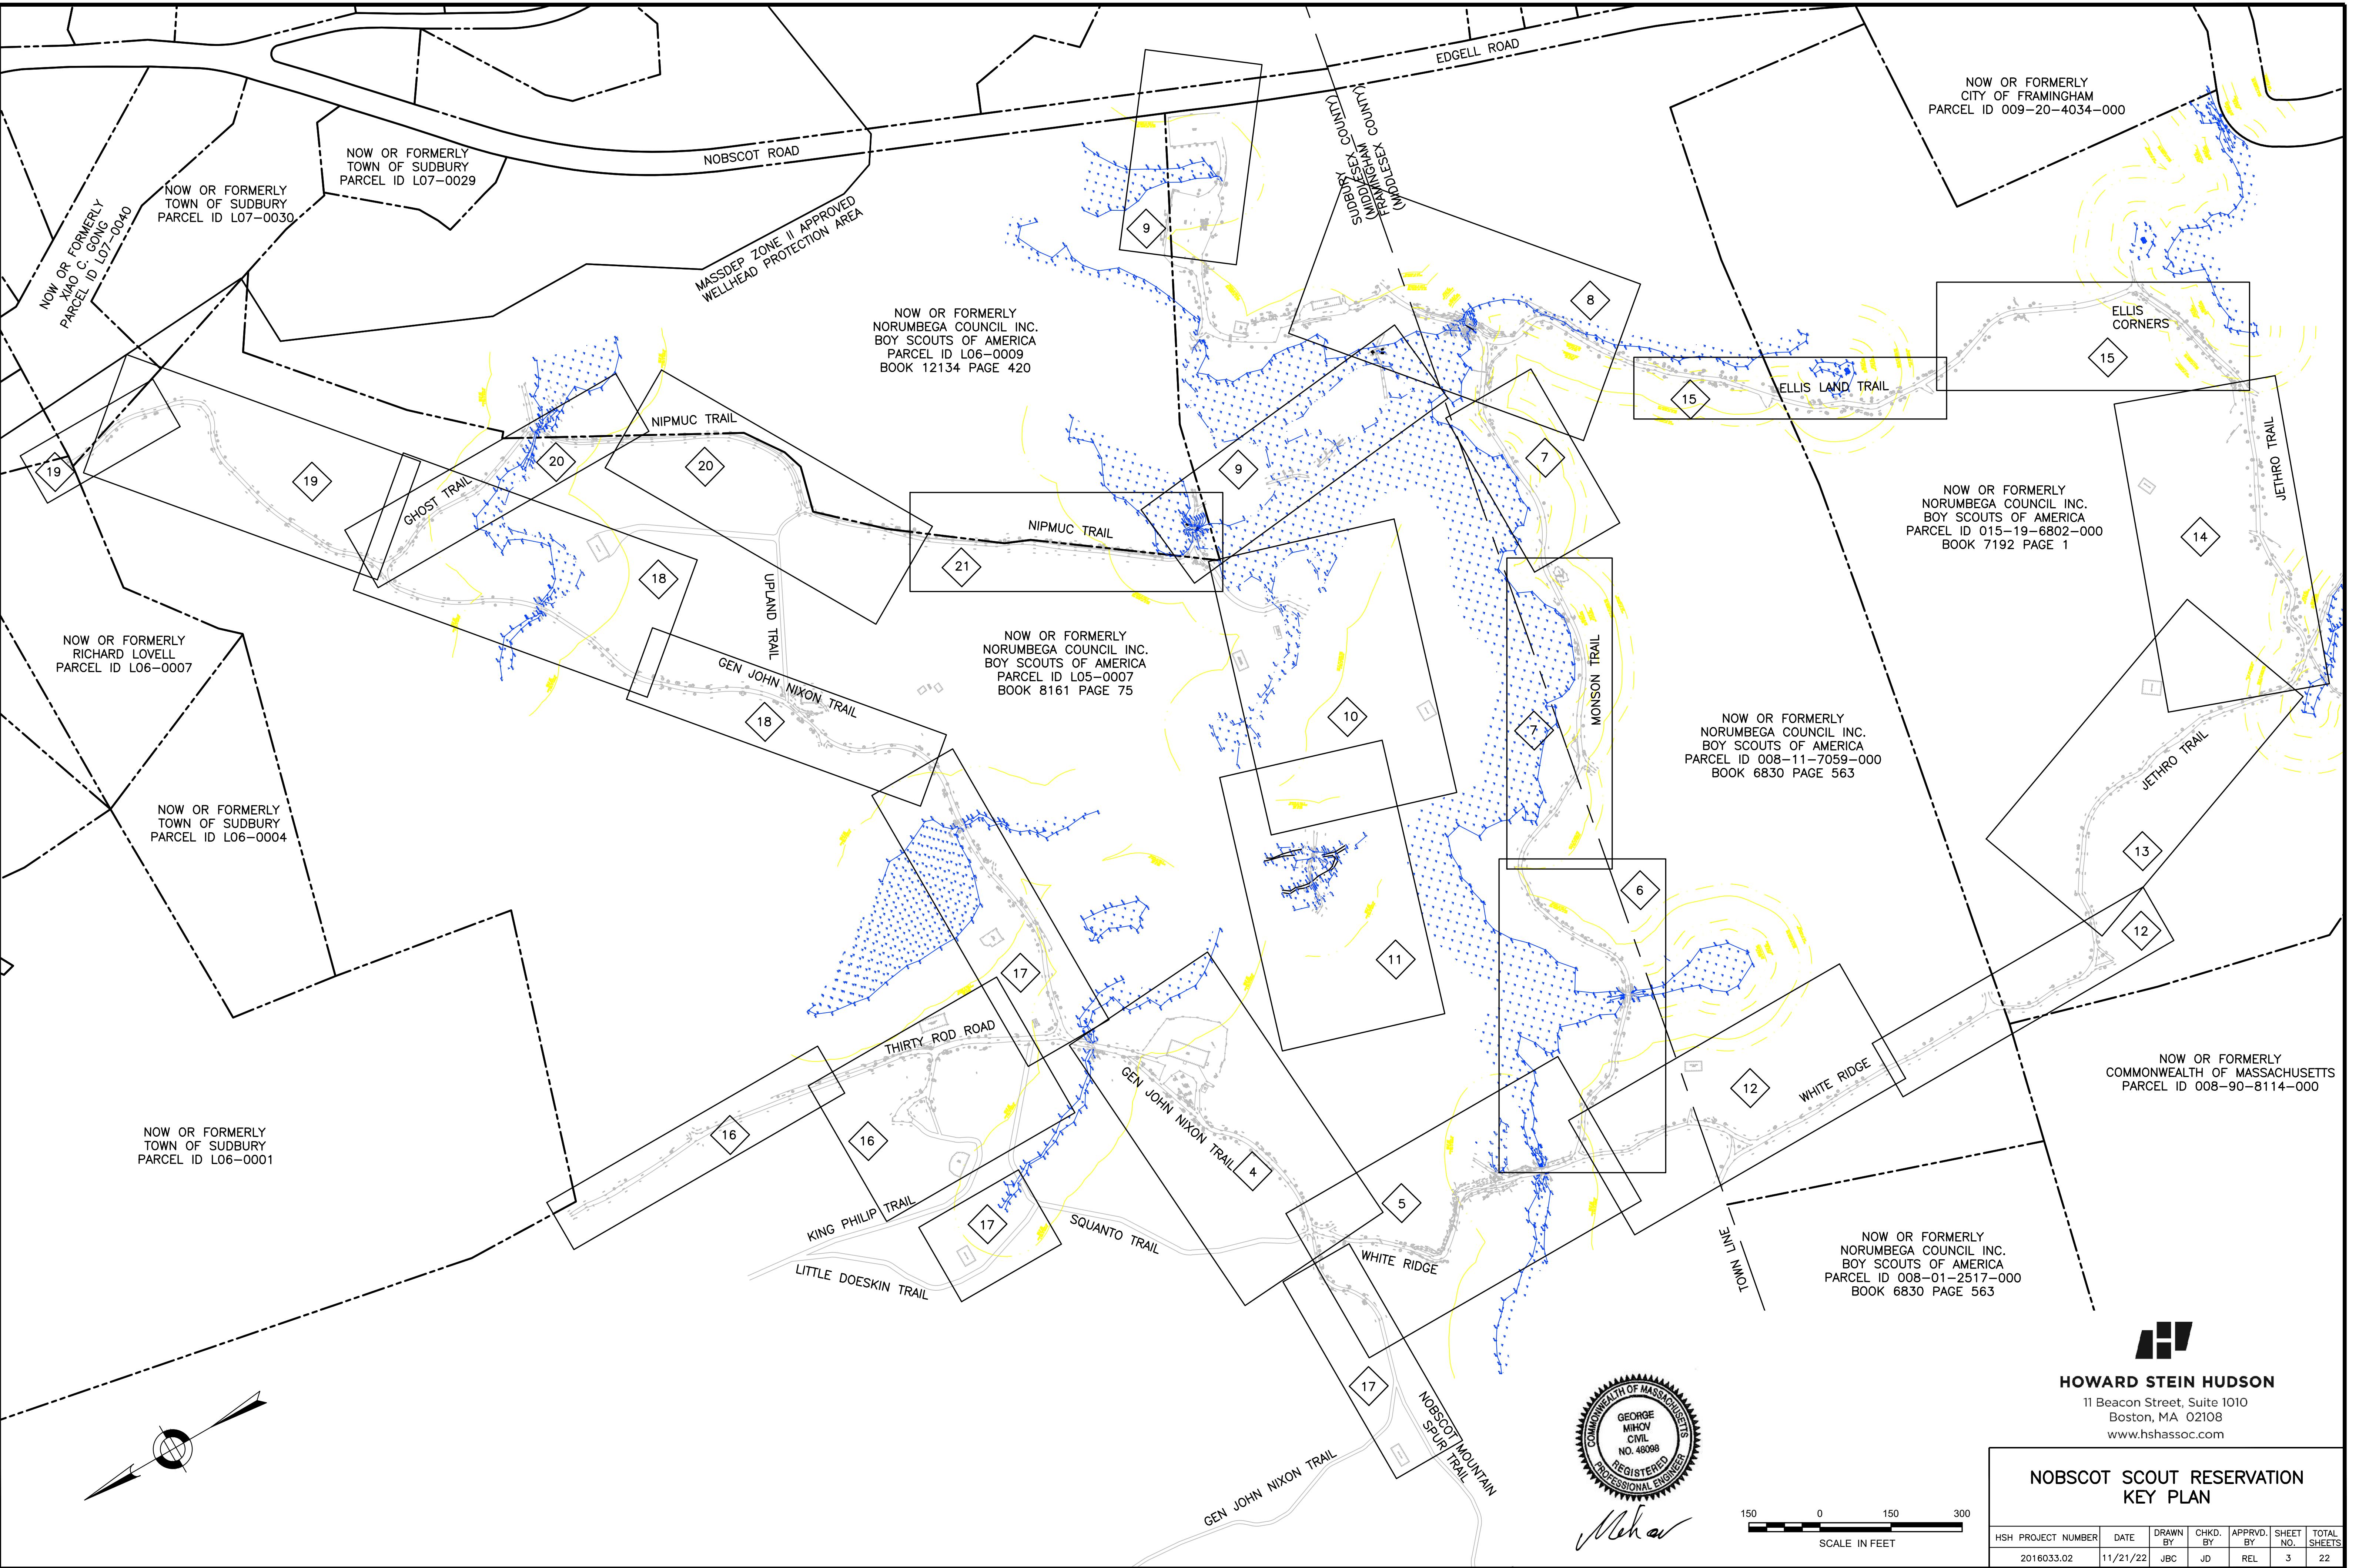


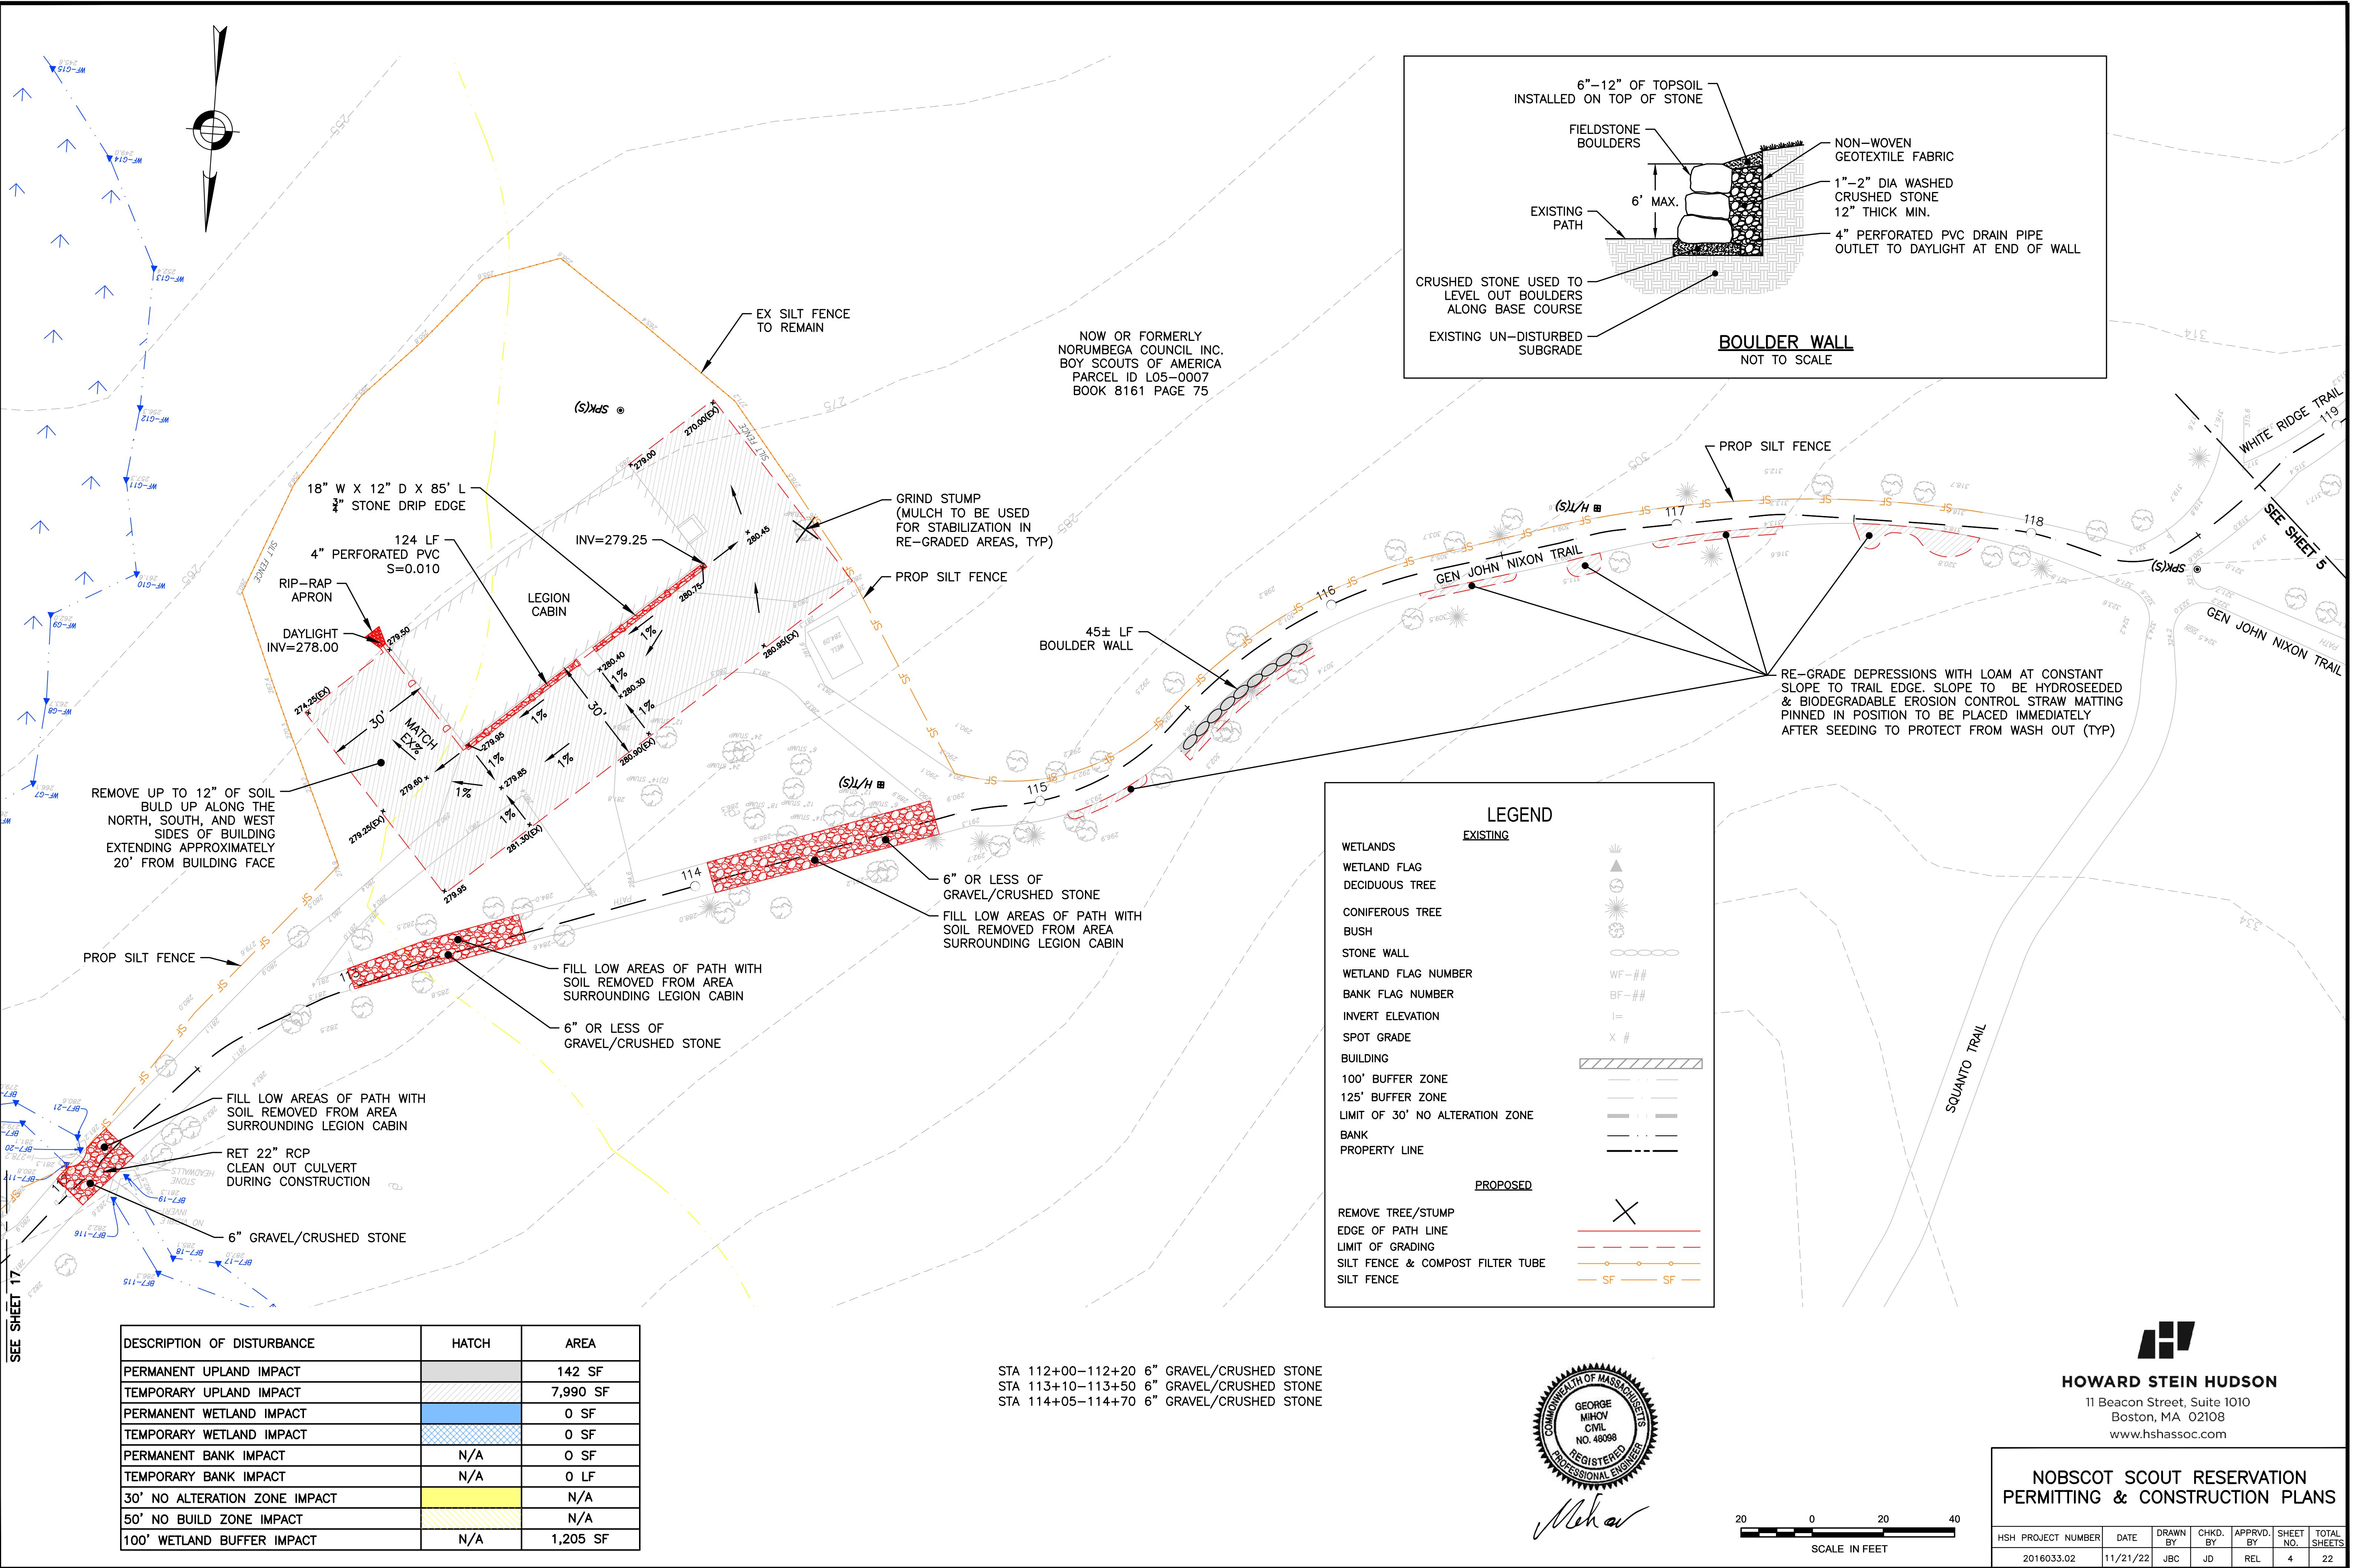


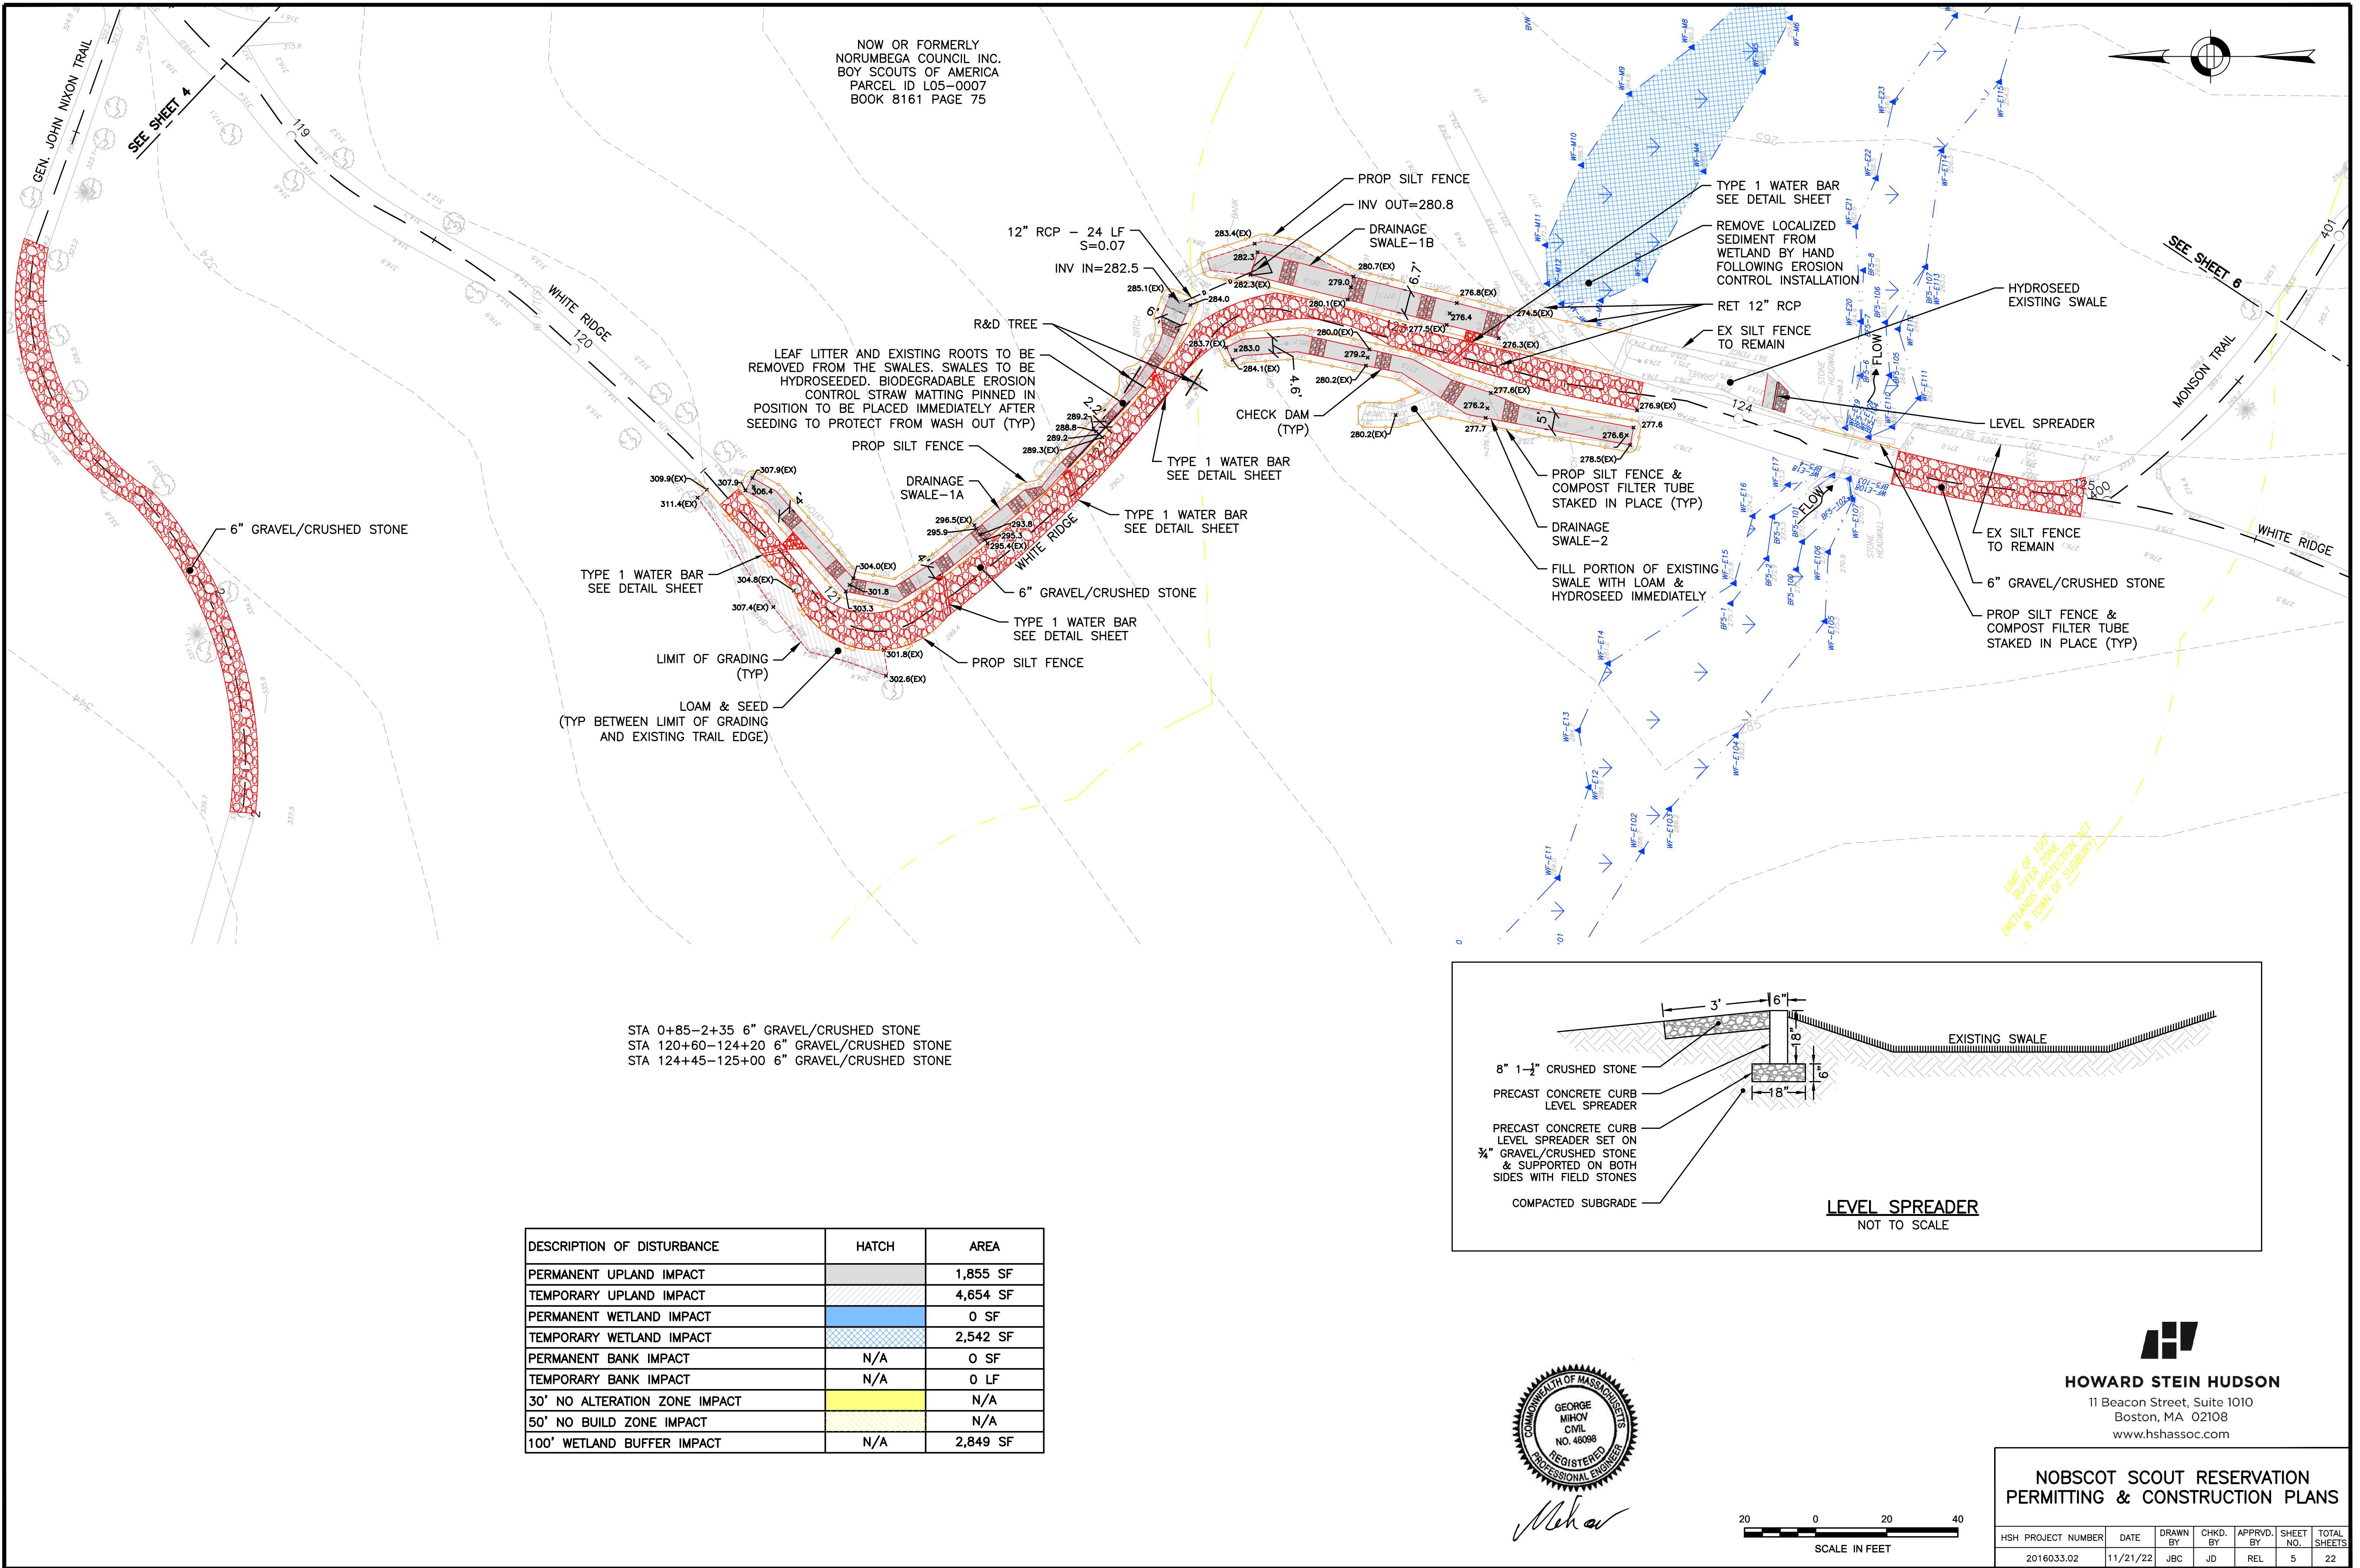

11/21/2022 L:\16033\CURRENT\UTSHEETS\16033_NOI_PLANS_SWALES.dwg
Joseph Connolly

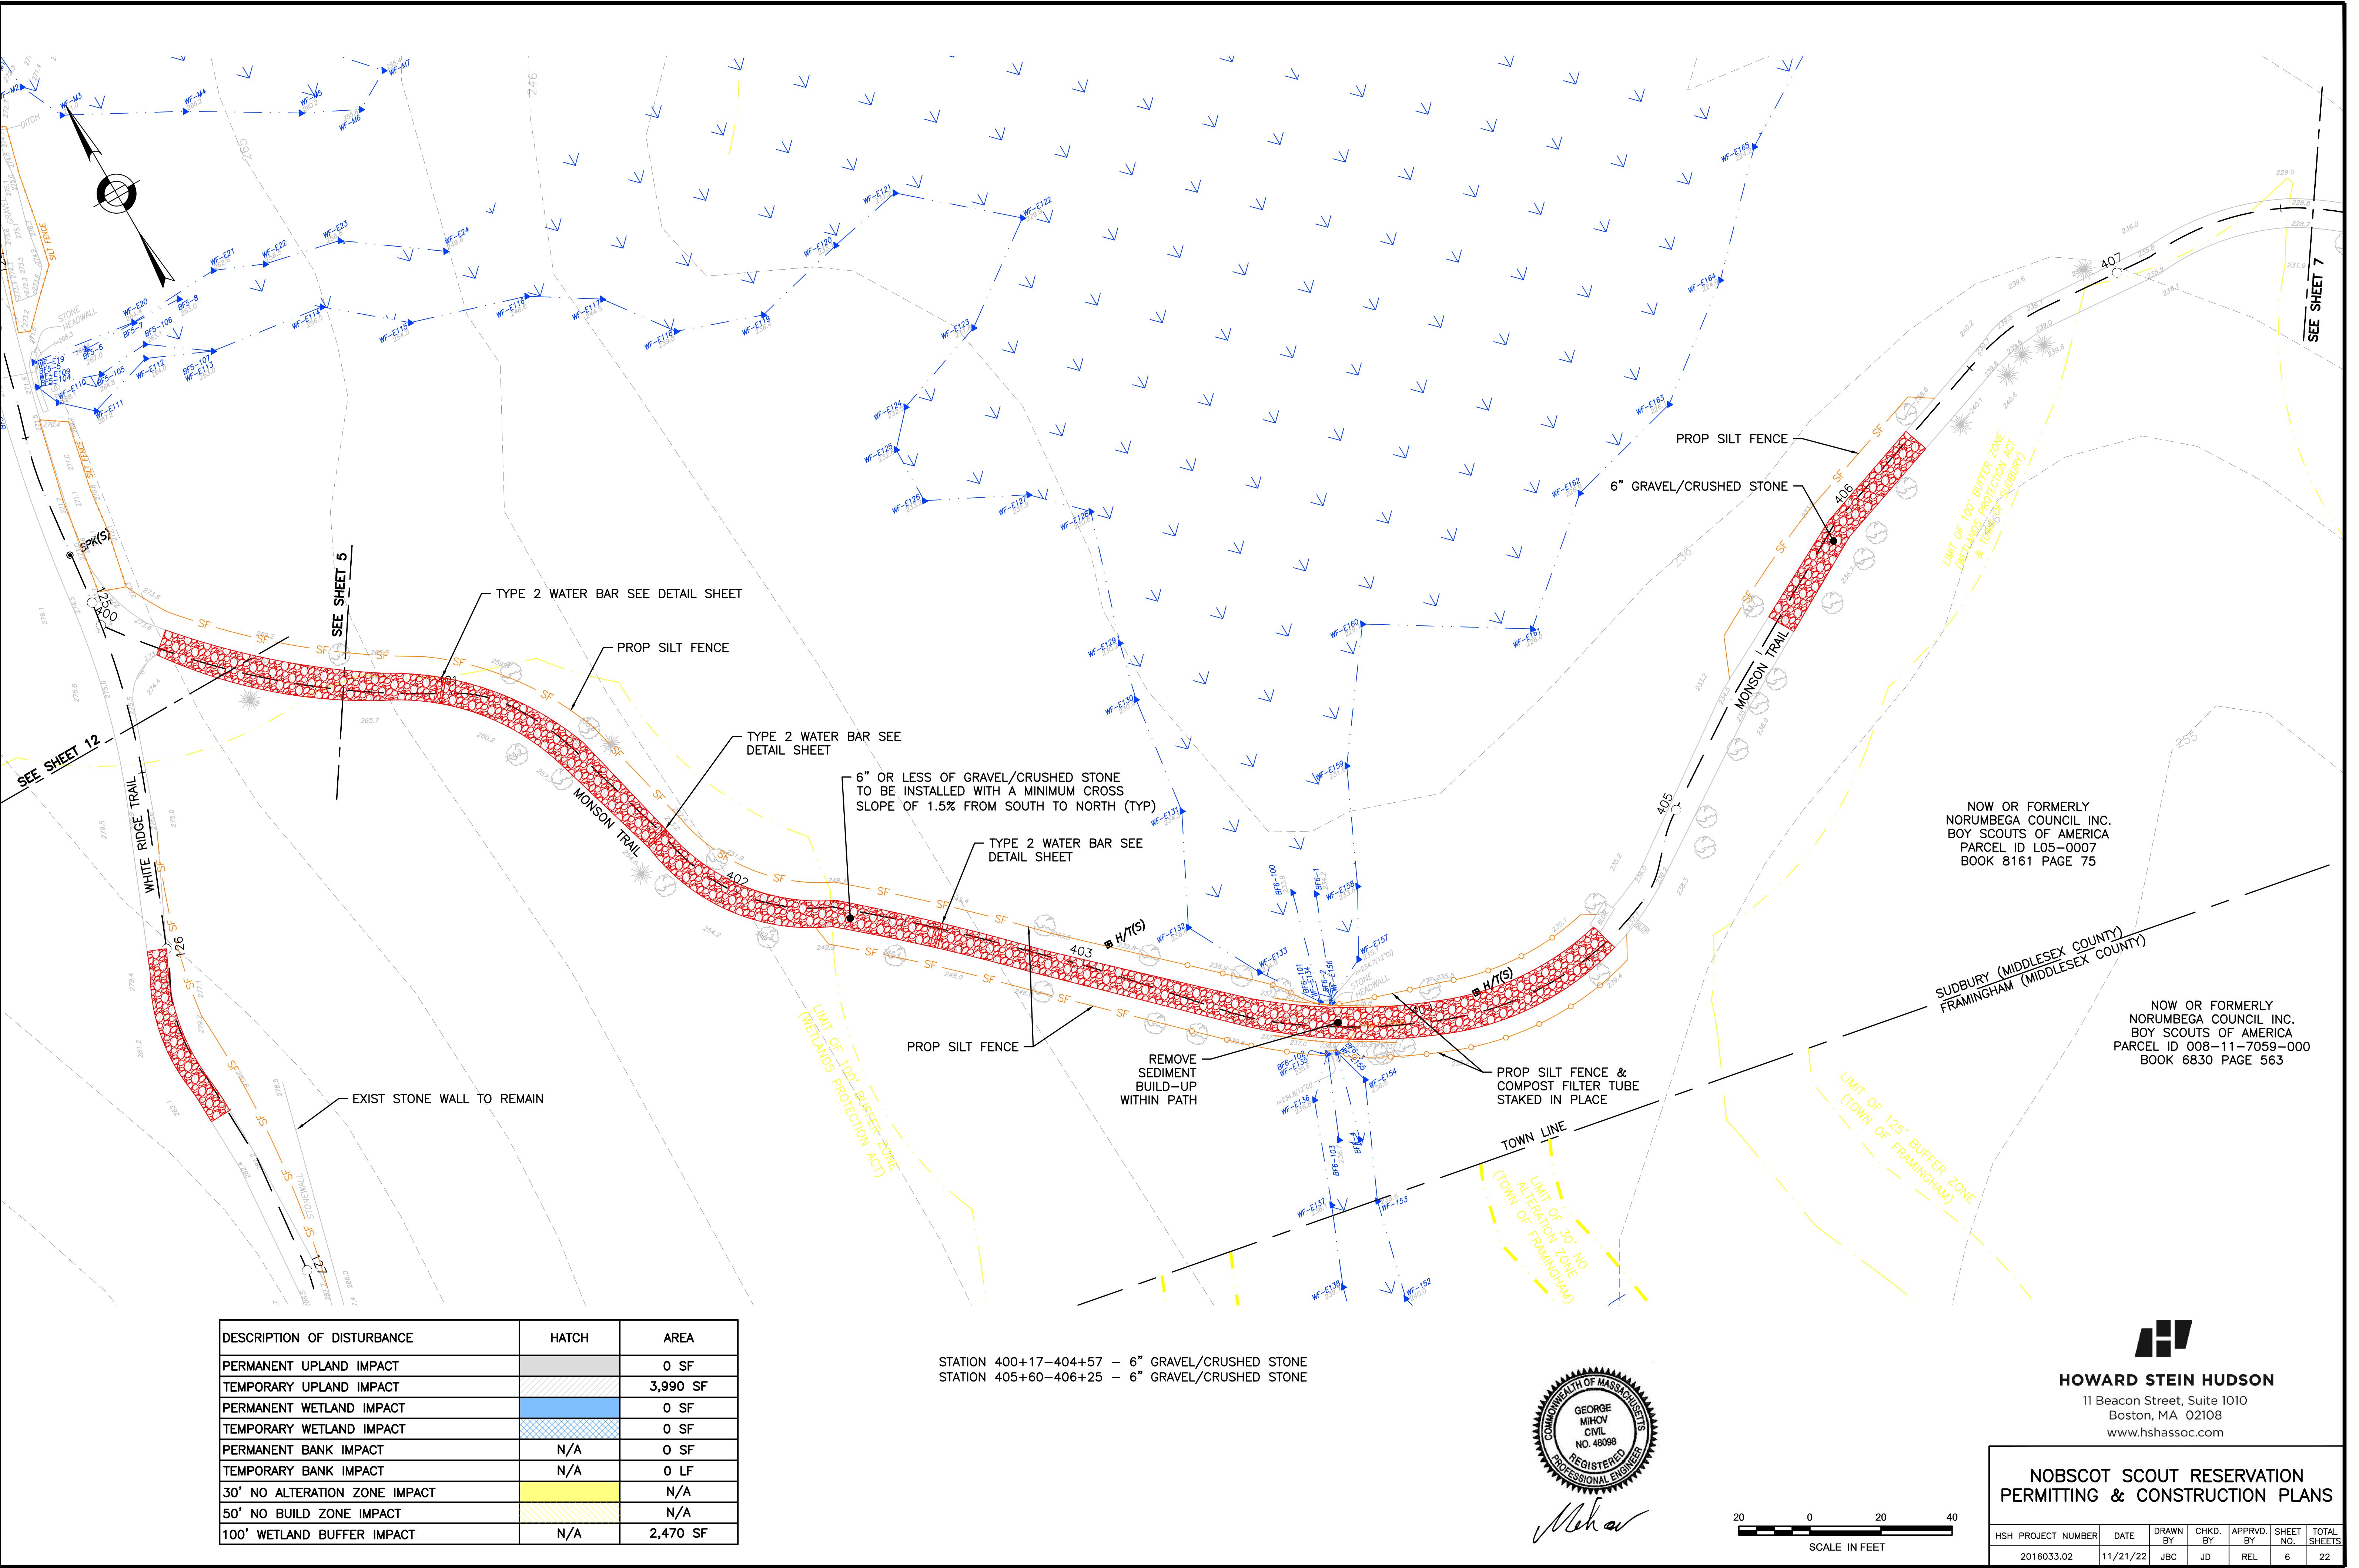

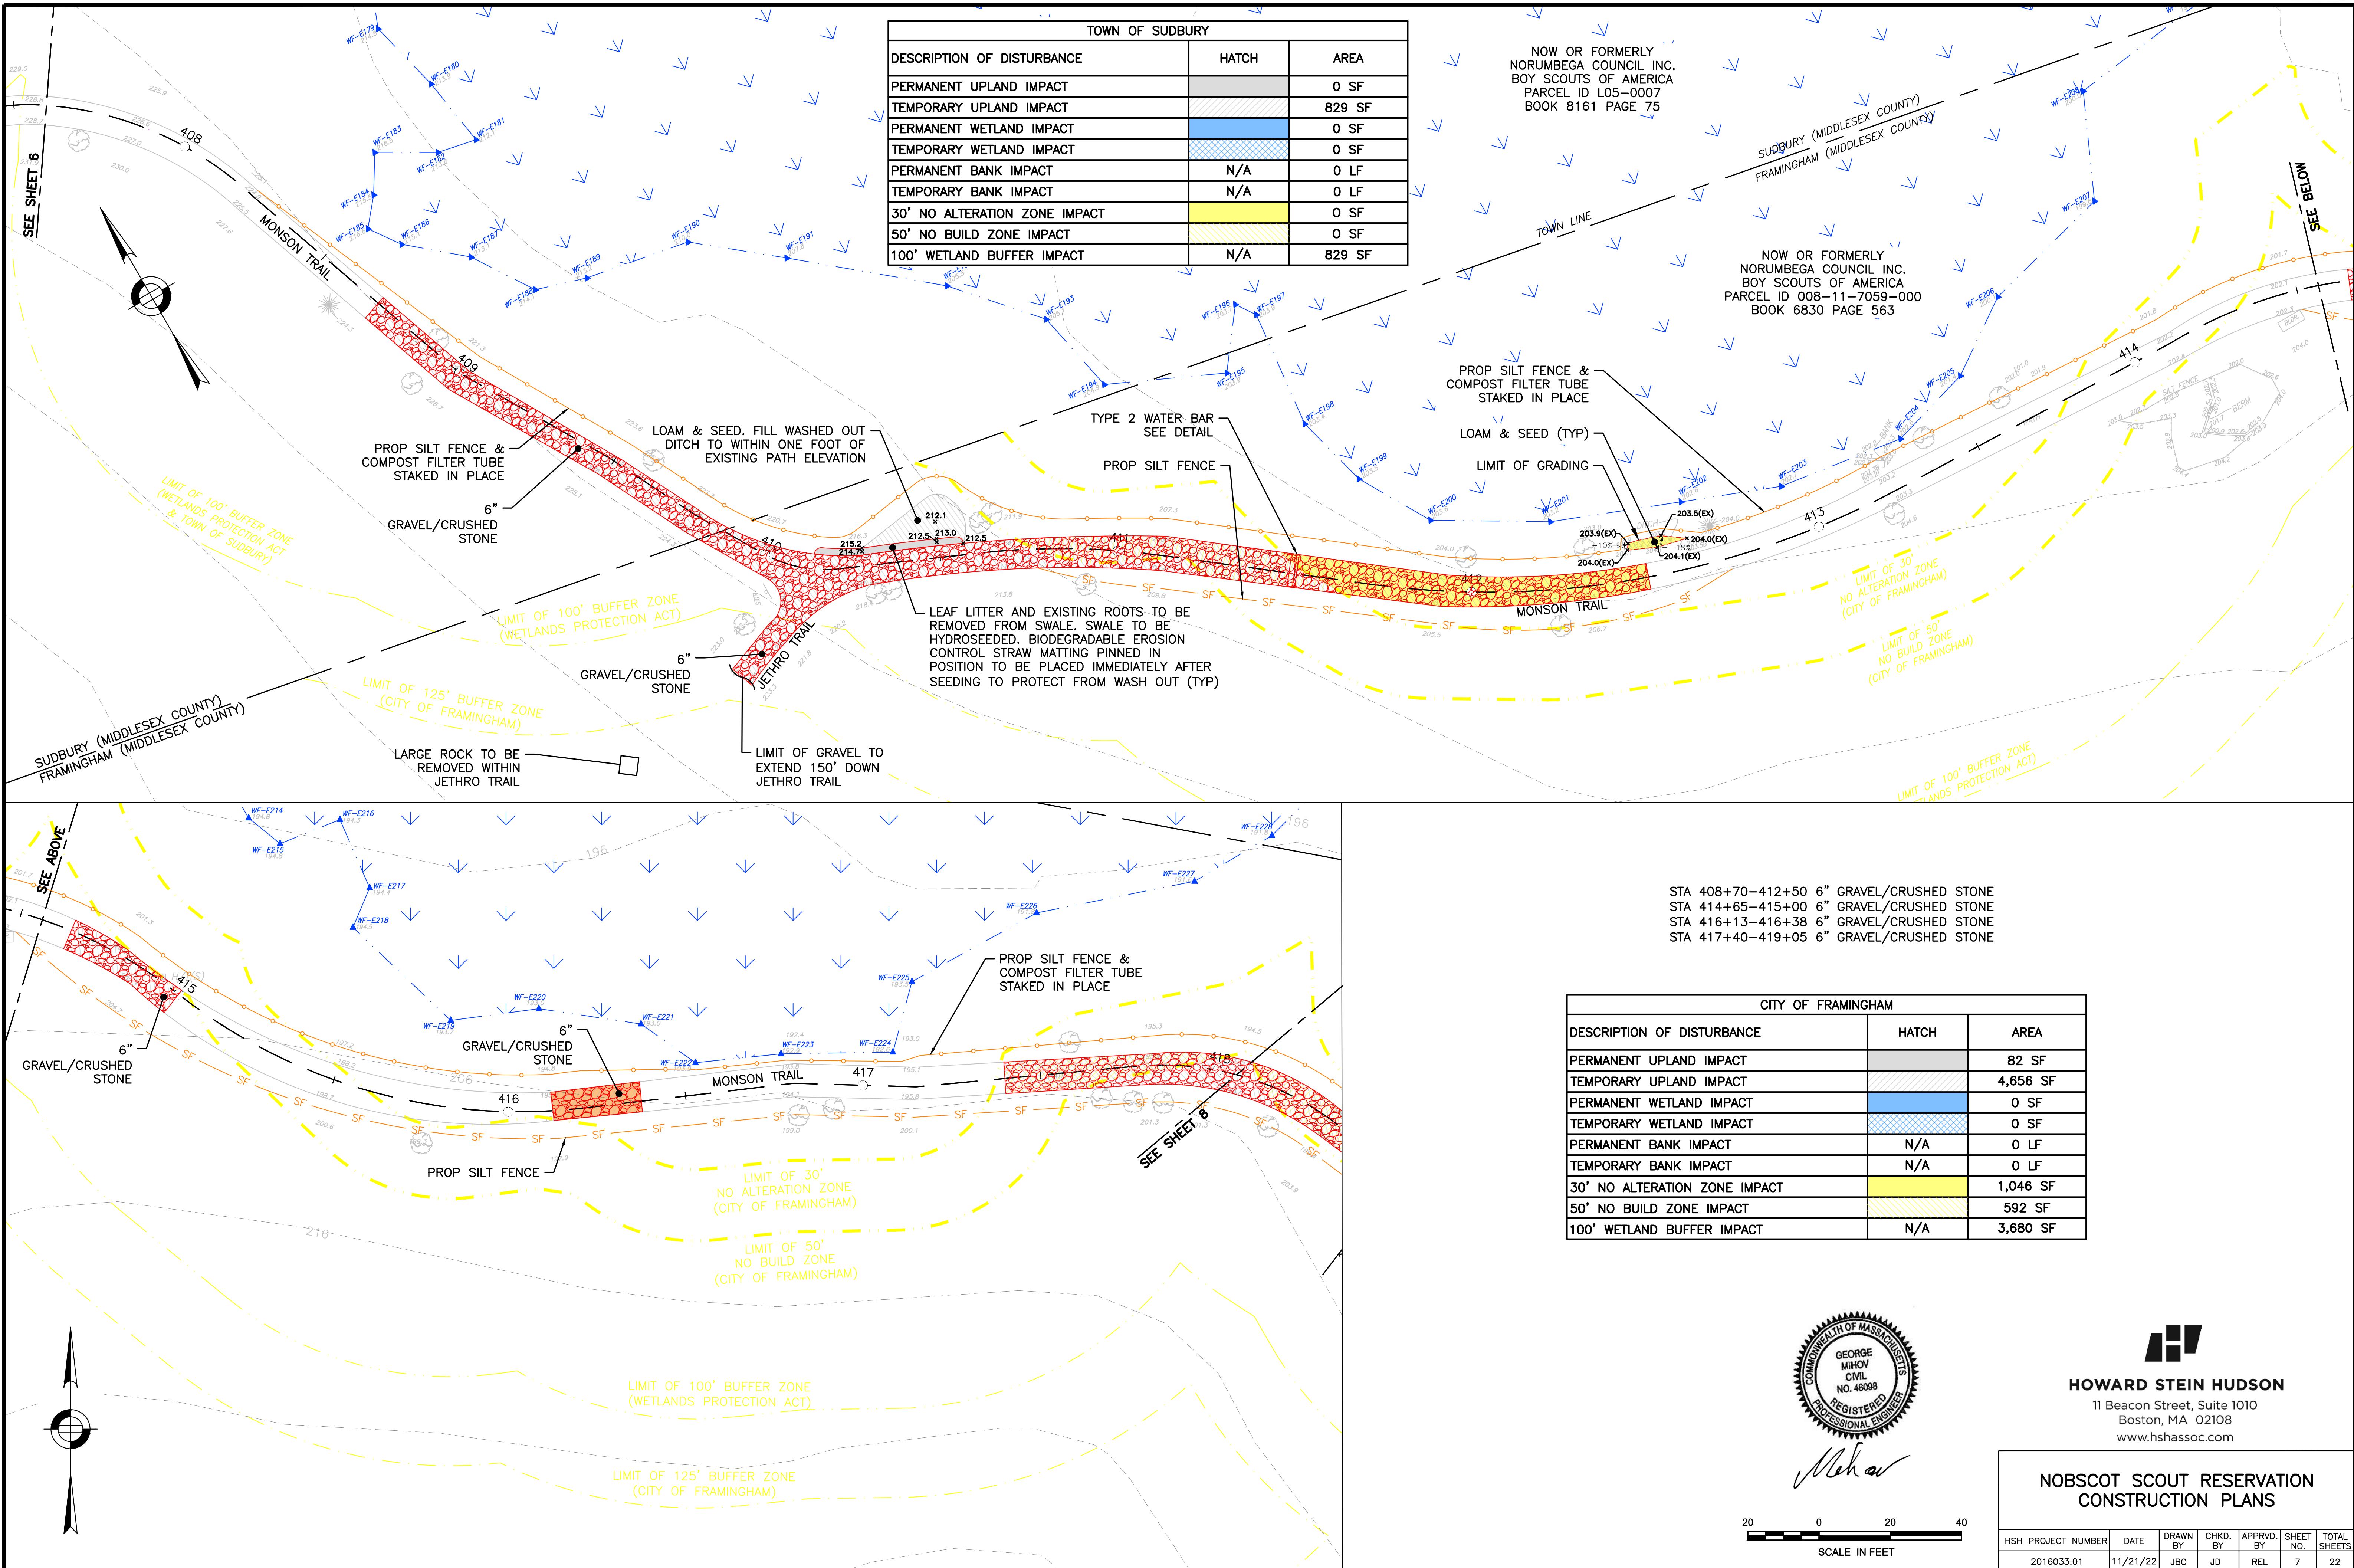

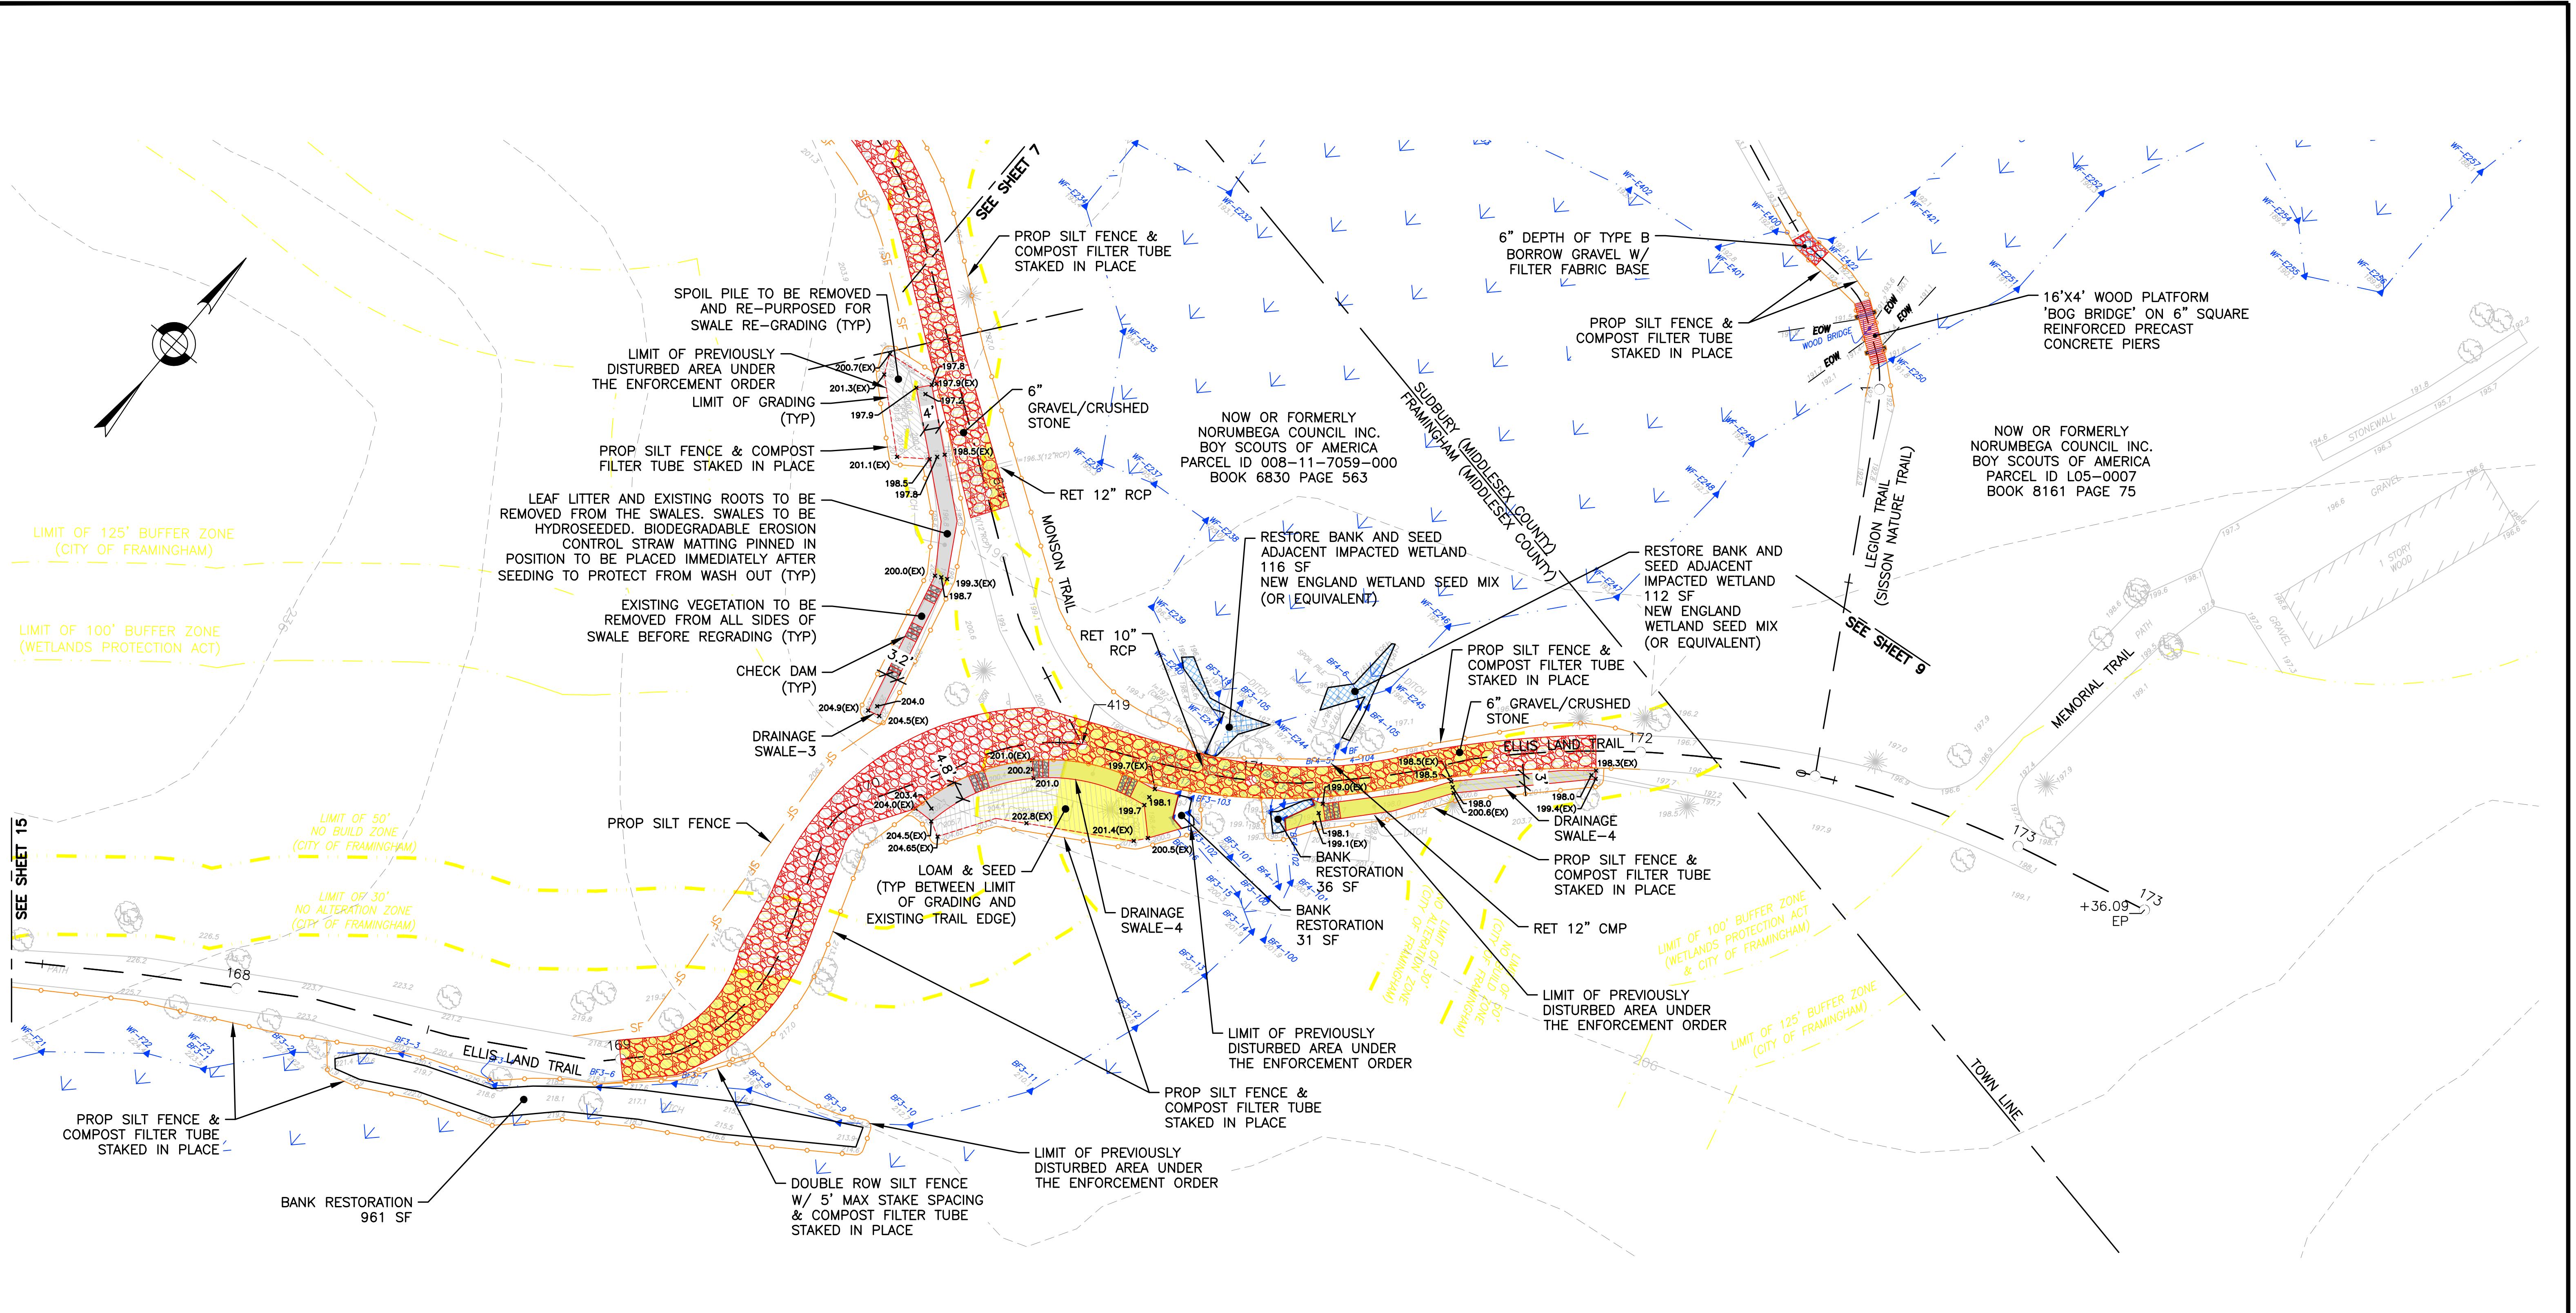

CITY OF FRAMINGHAM		
DESCRIPTION OF DISTURBANCE	HATCH	AREA
PERMANENT UPLAND IMPACT		958 SF
TEMPORARY UPLAND IMPACT		5,247 SF
PERMANENT WETLAND IMPACT		0 SF
TEMPORARY WETLAND IMPACT		229 SF
PERMANENT BANK IMPACT	N/A	0 LF
TEMPORARY BANK IMPACT	N/A	161 LF
30' NO ALTERATION ZONE IMPACT		2,151 SF
50' NO BUILD ZONE IMPACT		4,715 SF
100' WETLAND BUFFER IMPACT	N/A	6,205 SF


TOWN OF SUDBURY		
DESCRIPTION OF DISTURBANCE	HATCH	AREA
PERMANENT UPLAND IMPACT		0 SF
TEMPORARY UPLAND IMPACT		2 SF
PERMANENT WETLAND IMPACT		11 SF
TEMPORARY WETLAND IMPACT		38 SF
PERMANENT BANK IMPACT	N/A	0 LF
TEMPORARY BANK IMPACT	N/A	0 LF
30' NO ALTERATION ZONE IMPACT		0 SF
50' NO BUILD ZONE IMPACT		0 SF
100' WETLAND BUFFER IMPACT	N/A	2 SF



HOWARD STEIN HUDSON
11 Beacon Street, Suite 1010
Boston, MA 02108
www.hshassoc.com

NOBSCOT SCOUT RESERVATION PERMITTING & CONSTRUCTION PLANS

HSH PROJECT NUMBER	DATE	DRAWN BY	CHKD. BY	APPRVD. BY	SHEET NO.	TOTAL SHEETS
2016033.02	11/21/22	JBC	JD	REL	8	22

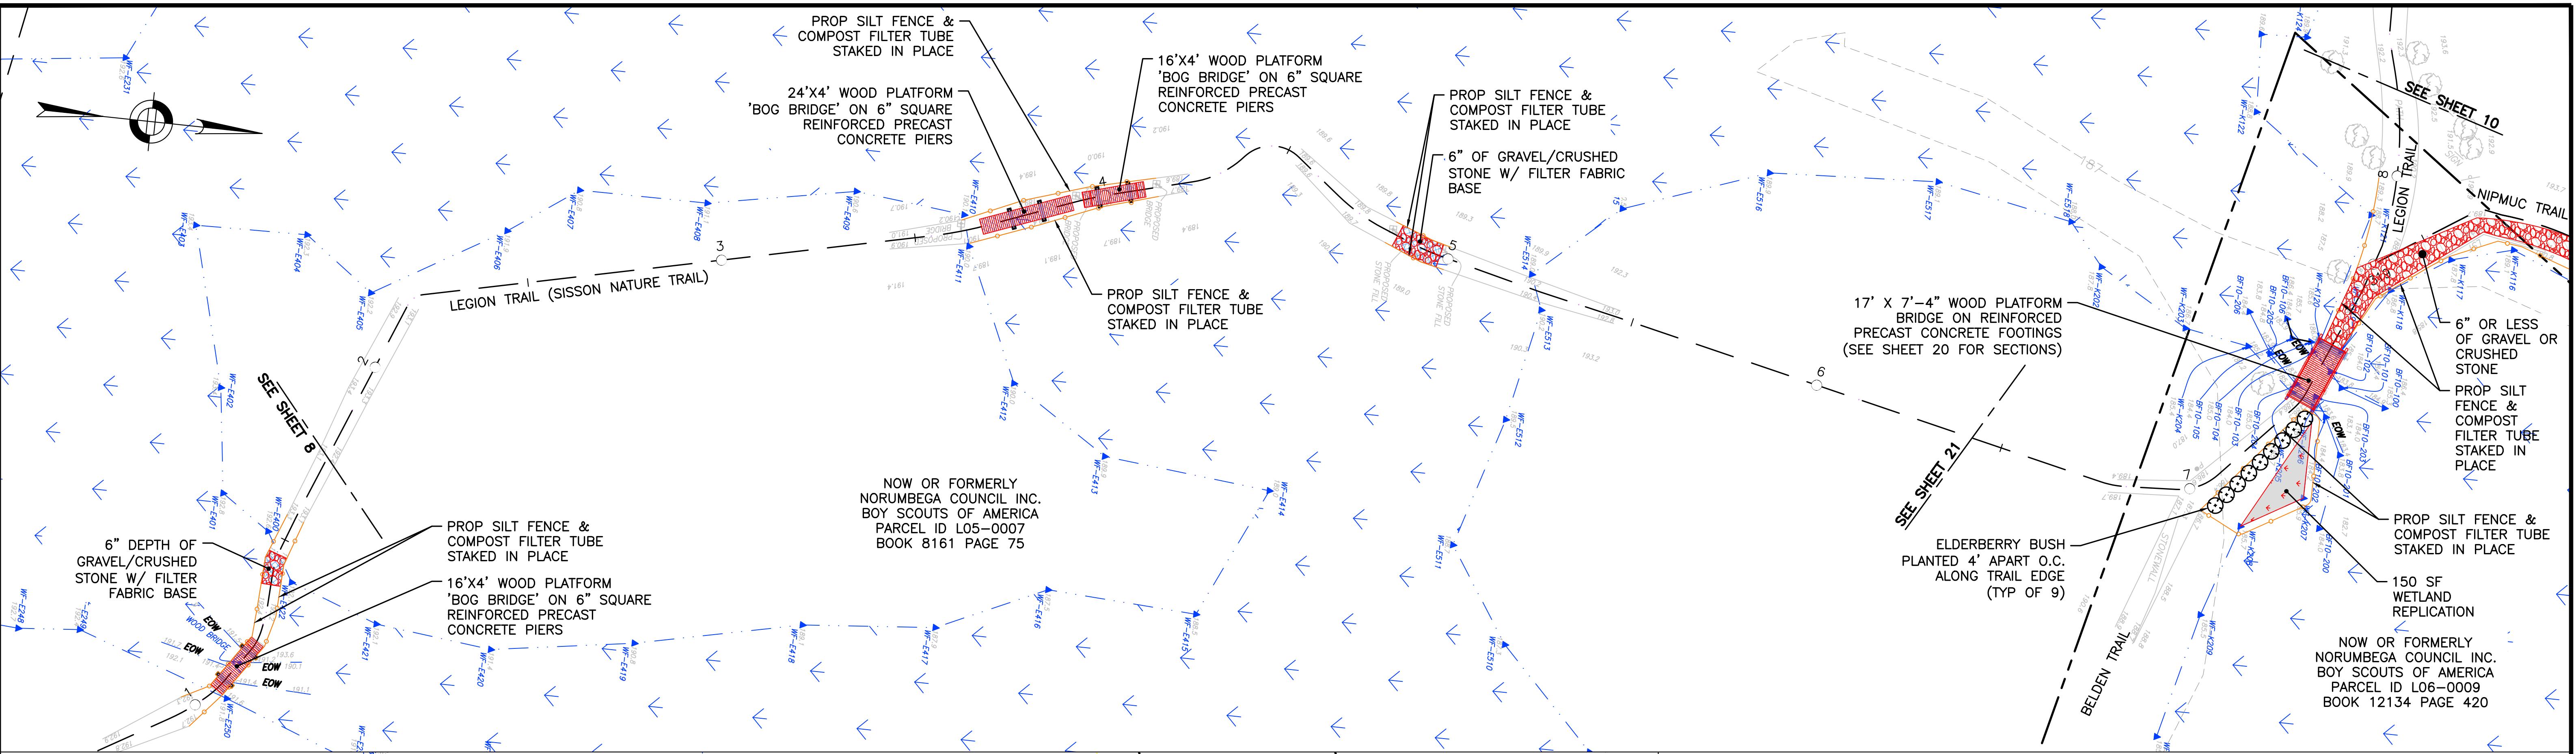


STA 4+86-4+98 6" TYPE B GRAVEL/CRUSHED STONE W/ FILTER FABRIC BASE

NOW OR FORMERLY
NORUMBEGA COUNCIL INC.
BOY SCOUTS OF AMERICA
PARCEL ID L06-0009
BOOK 12134 PAGE 420


NOB

DESCRIPTION OF DISTURBANCE	HATCH	AREA
PERMANENT UPLAND IMPACT		11 SF
TEMPORARY UPLAND IMPACT	/	60 SF
PERMANENT WETLAND IMPACT	#	47 SF
TEMPORARY WETLAND IMPACT	##	74 SF
PERMANENT BANK IMPACT	N/A	0 SF
TEMPORARY BANK IMPACT	N/A	0 LF
30' NO ALTERATION ZONE IMPACT		N/A
50' NO BUILD ZONE IMPACT	/	N/A
100' WETLAND BUFFER IMPACT	N/A	11 SF

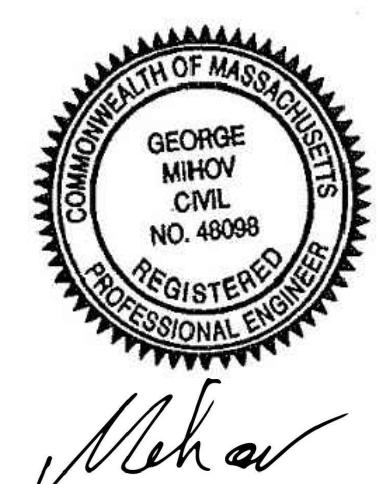


HOWARD STEIN HUDSON
11 Beacon Street, Suite 1010
Boston, MA 02108
www.hshassoc.com

NOW OR FORMERLY
NORUMBEGA COUNCIL INC
BOY SCOUTS OF AMERICA
PARCEL ID L05-0007
BOOK 8161 PAGE 75

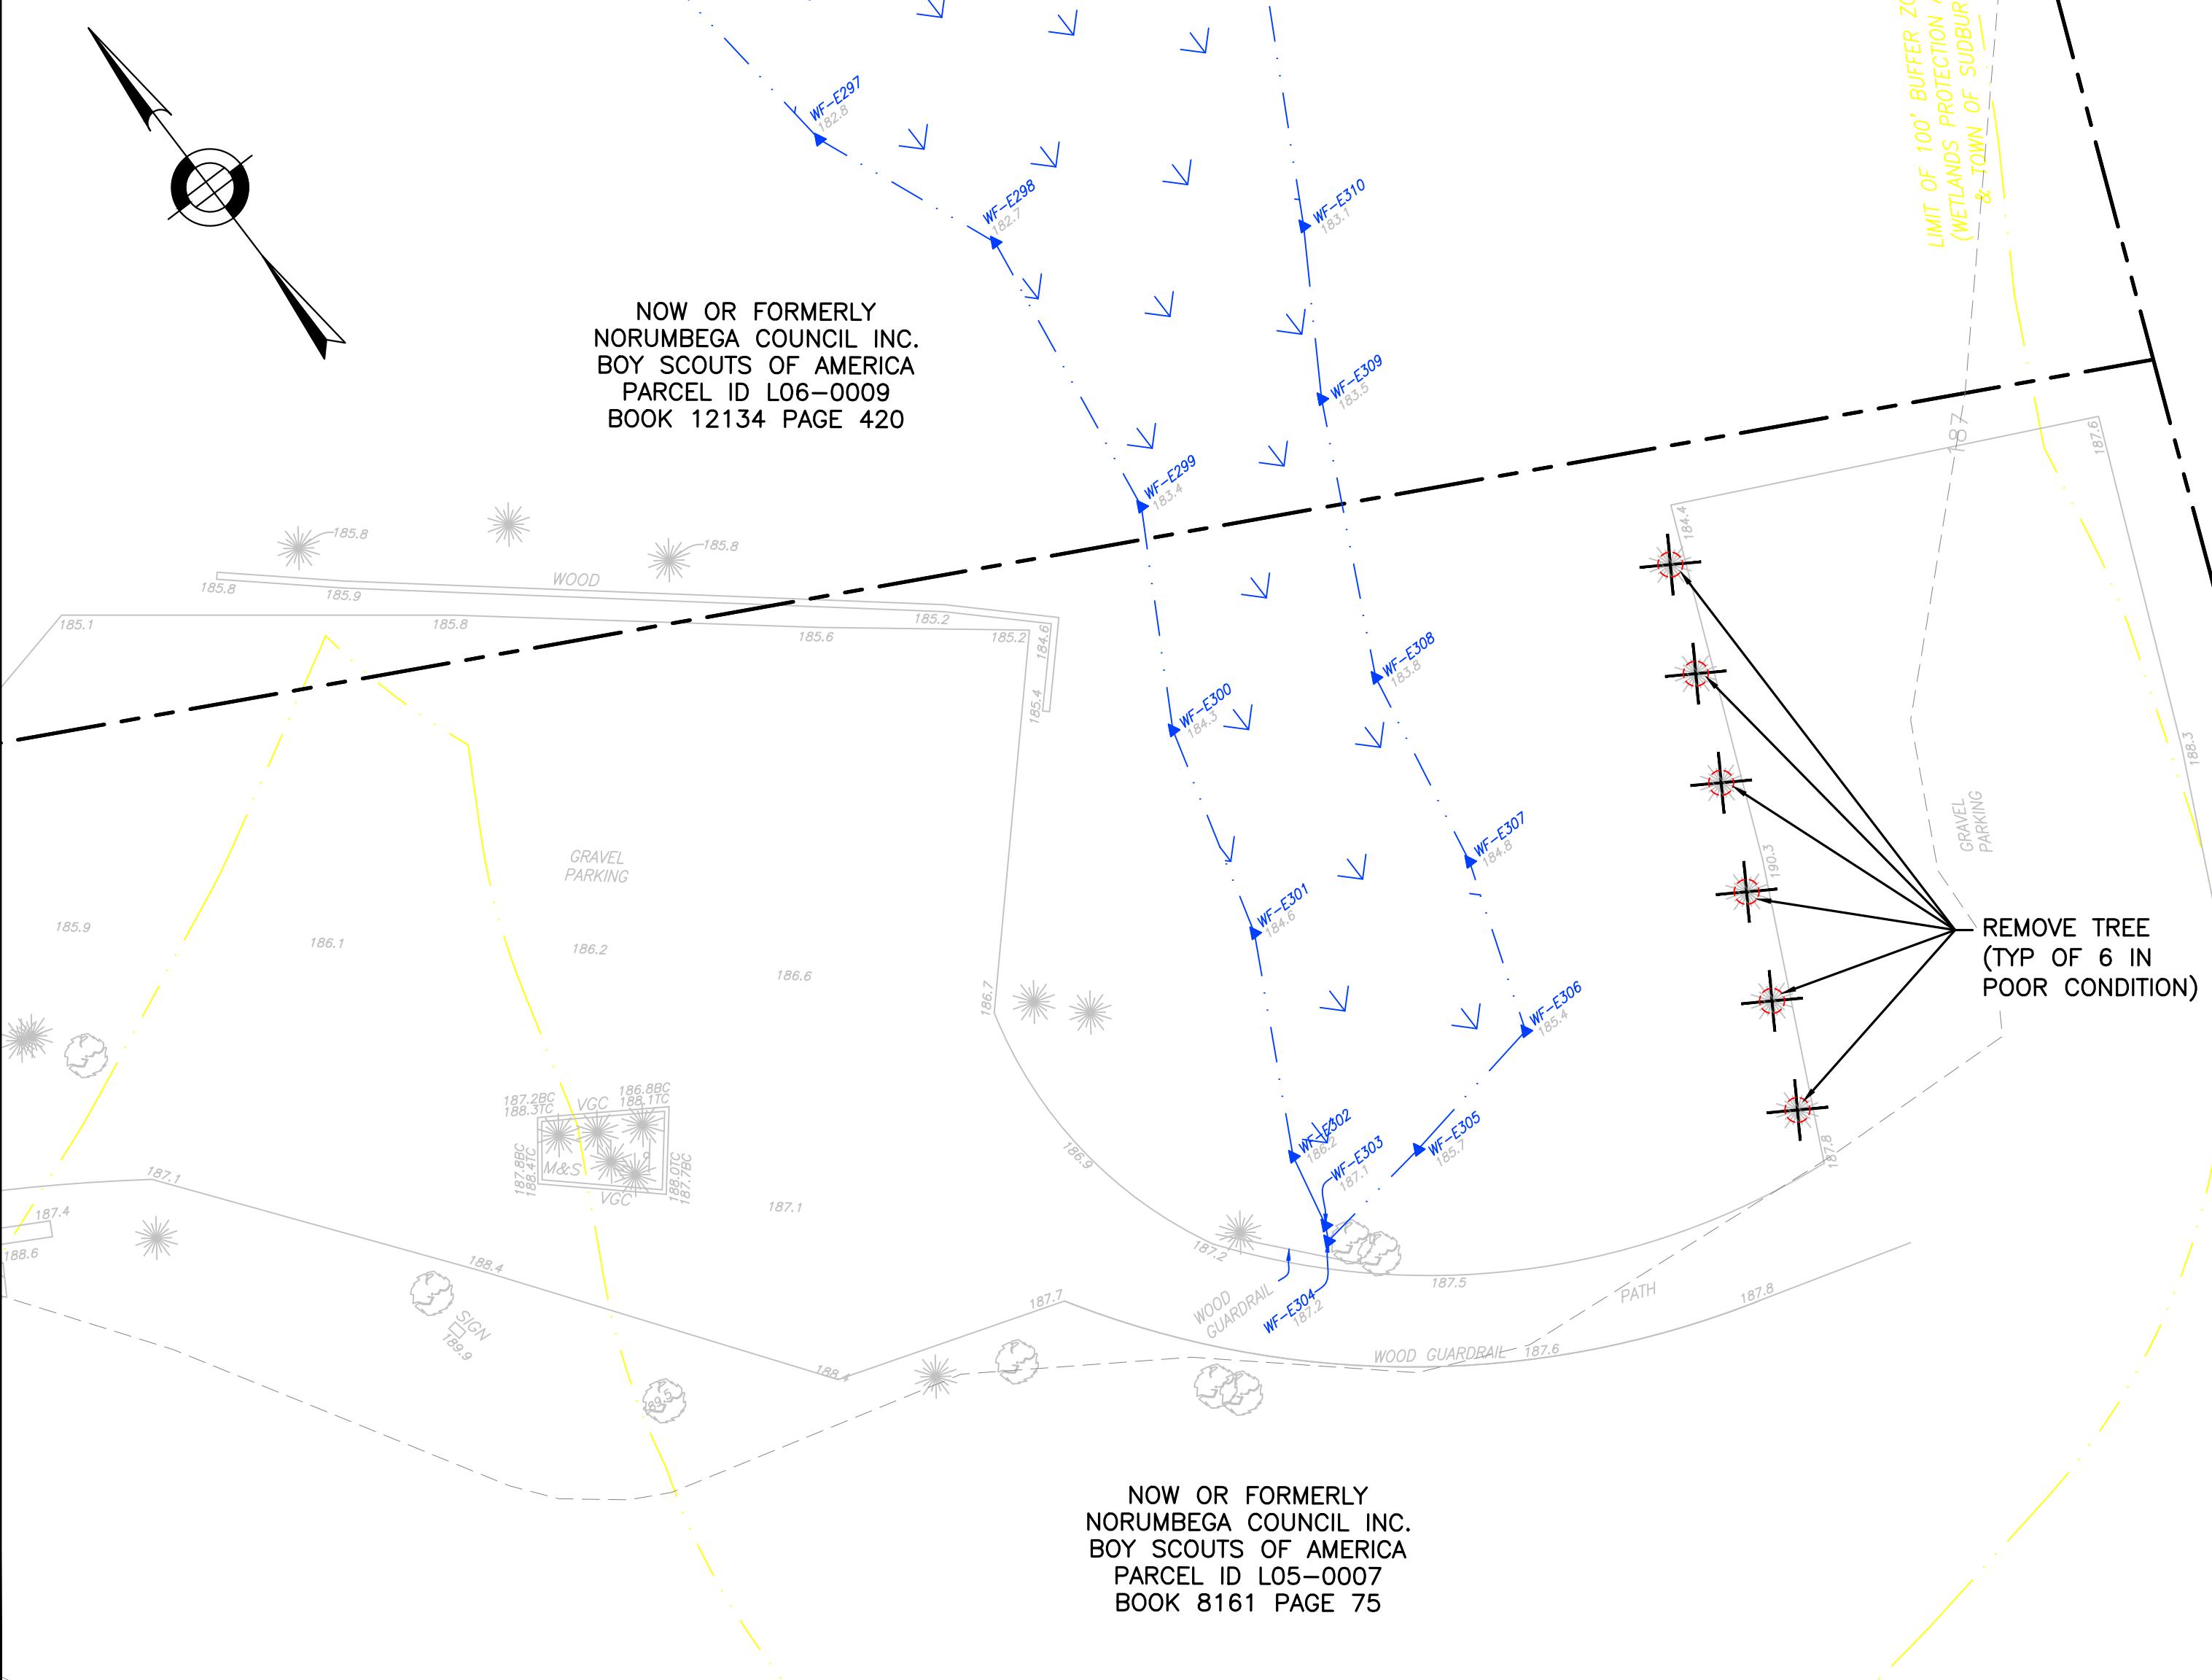






NOBSCOT SCOUT RESERVATION PERMITTING & CONSTRUCTION PLANS

NOBSCOT SCOUT RESERVATION PERMITTING & CONSTRUCTION PLANS

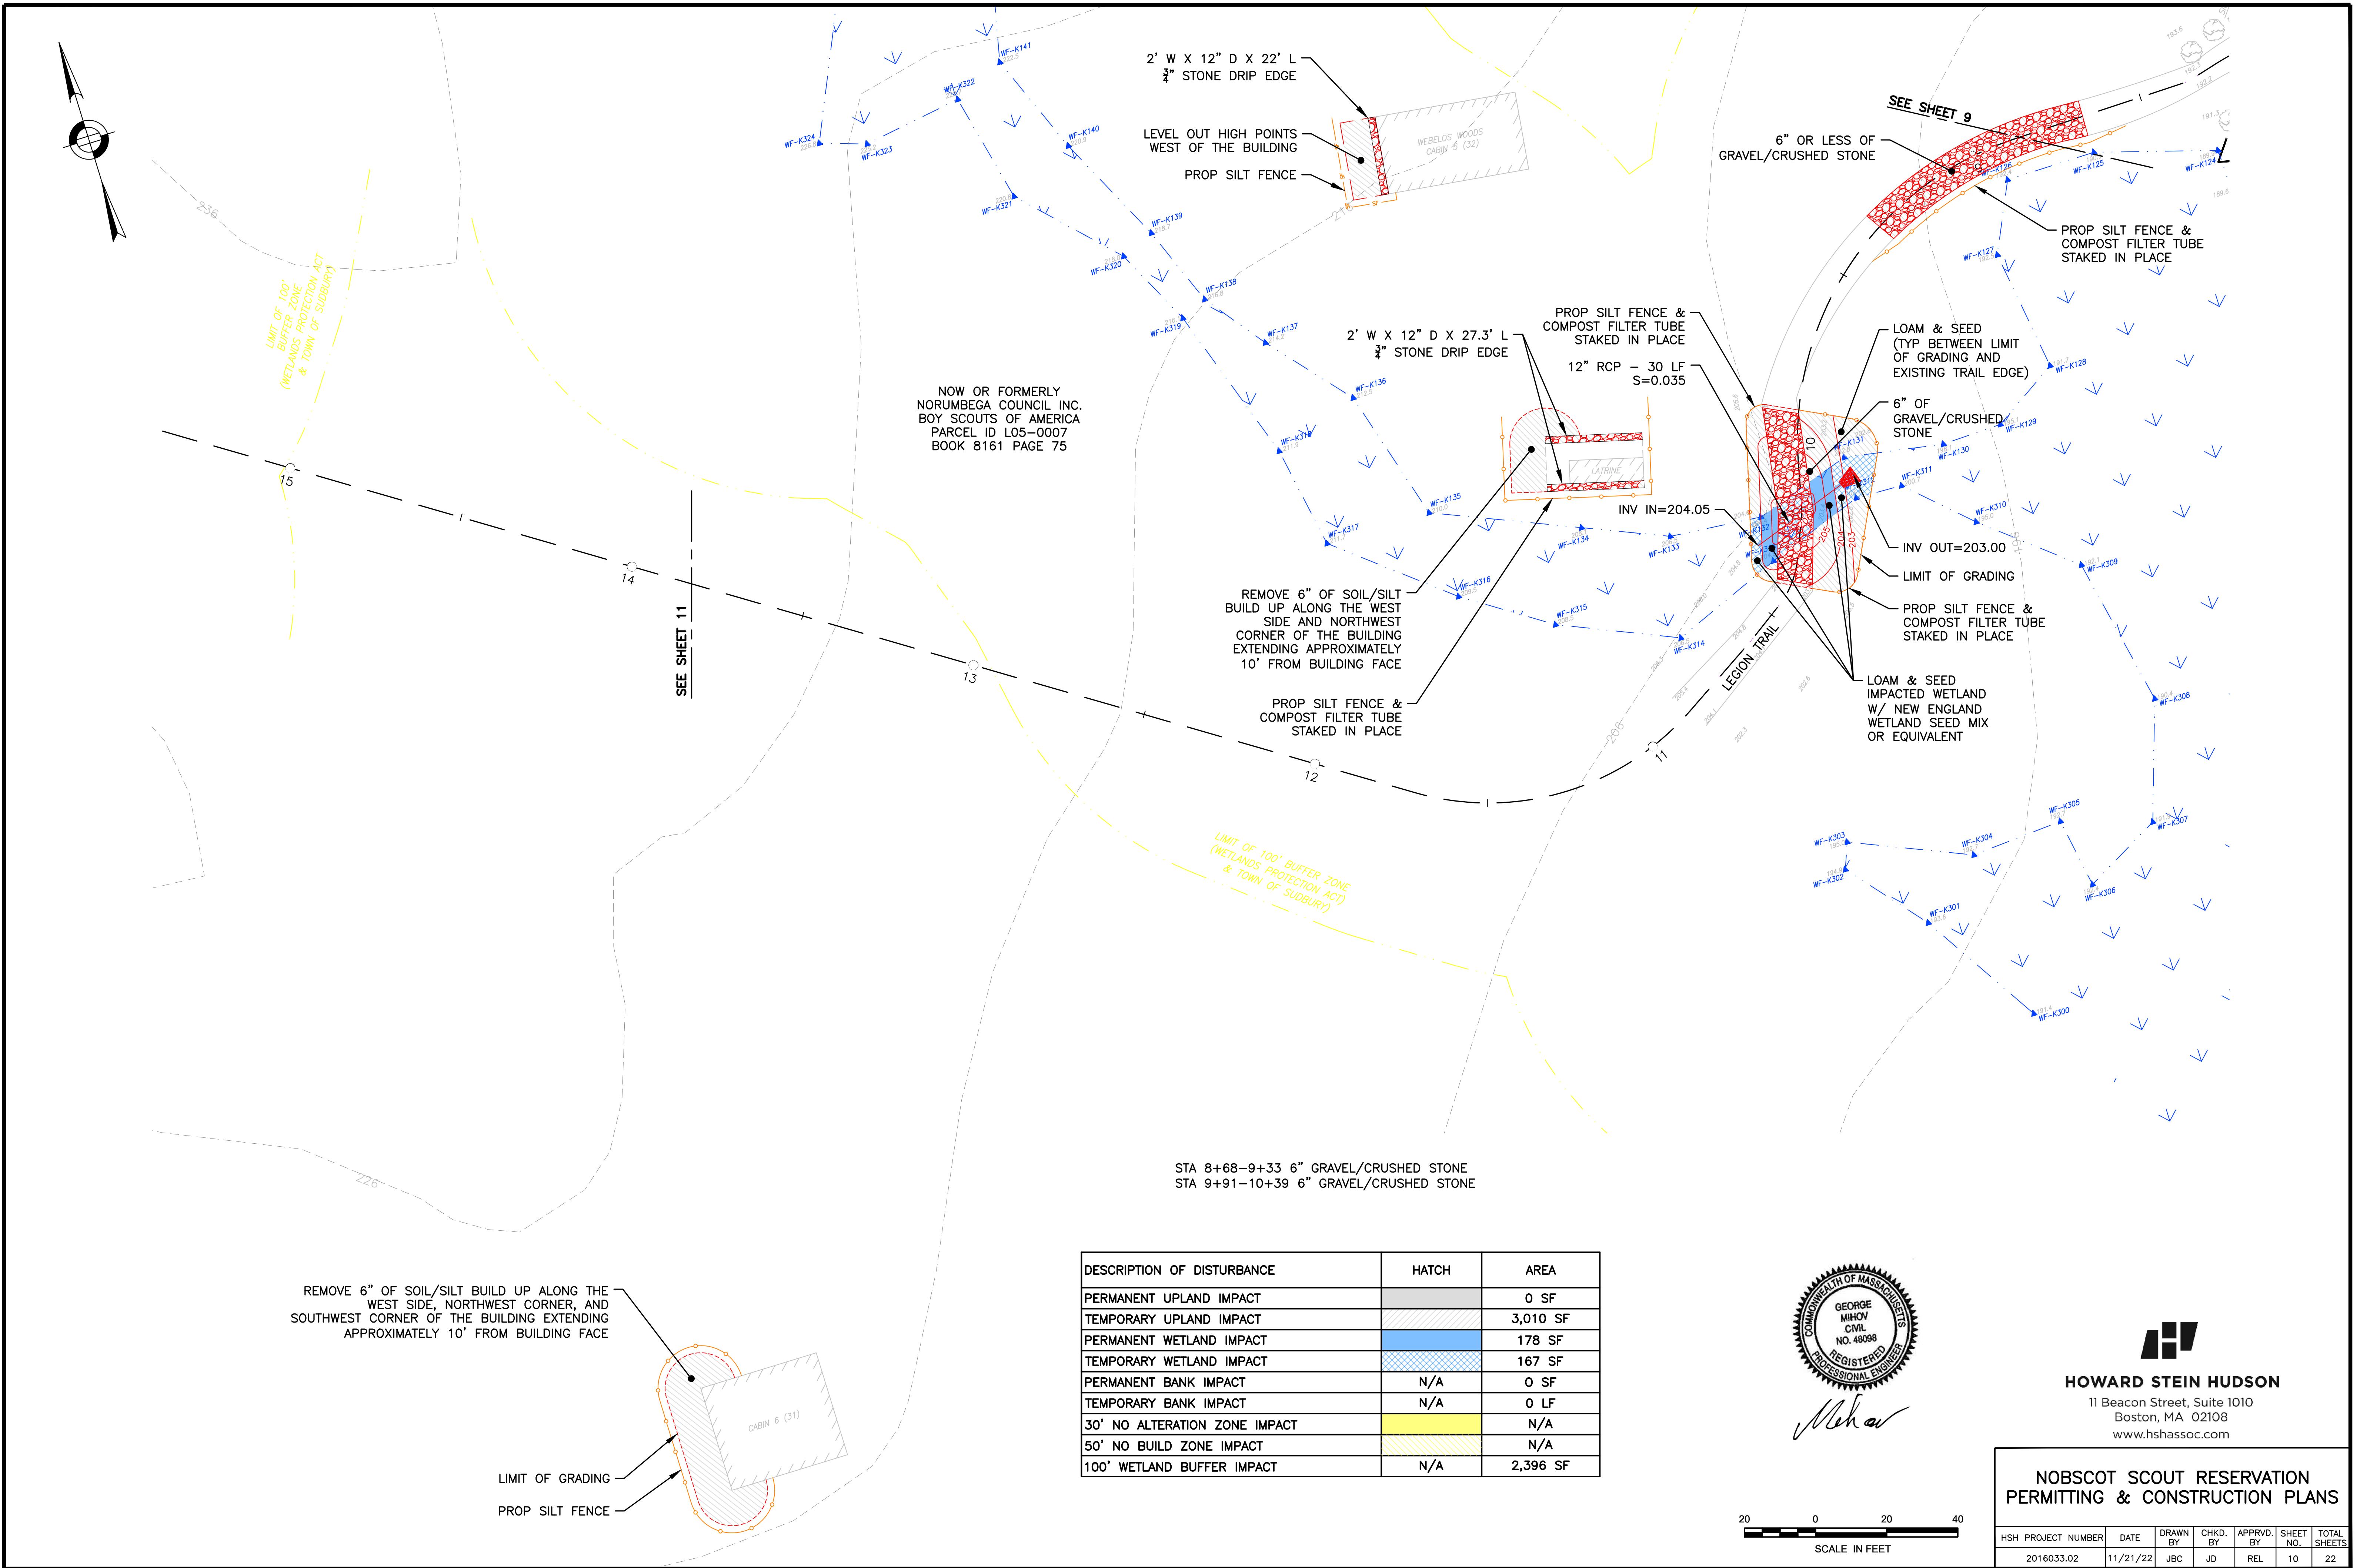


11/21/2022 L:\16033\CURRENT\UTSHEETS\16033_NOI PLANS.dwg
Joseph Connolly


DESCRIPTION OF DISTURBANCE	HATCH	AREA
PERMANENT UPLAND IMPACT		36 SF
TEMPORARY UPLAND IMPACT		32 SF
PERMANENT WETLAND IMPACT	Blue Hatched	17 SF
TEMPORARY WETLAND IMPACT	Blue Hatched	125 SF
PERMANENT BANK IMPACT	N/A	10 LF
TEMPORARY BANK IMPACT	N/A	12 LF
30' NO ALTERATION ZONE IMPACT	Yellow Hatched	N/A
50' NO BUILD ZONE IMPACT	Yellow Hatched	N/A
100' WETLAND BUFFER IMPACT	N/A	68 SF

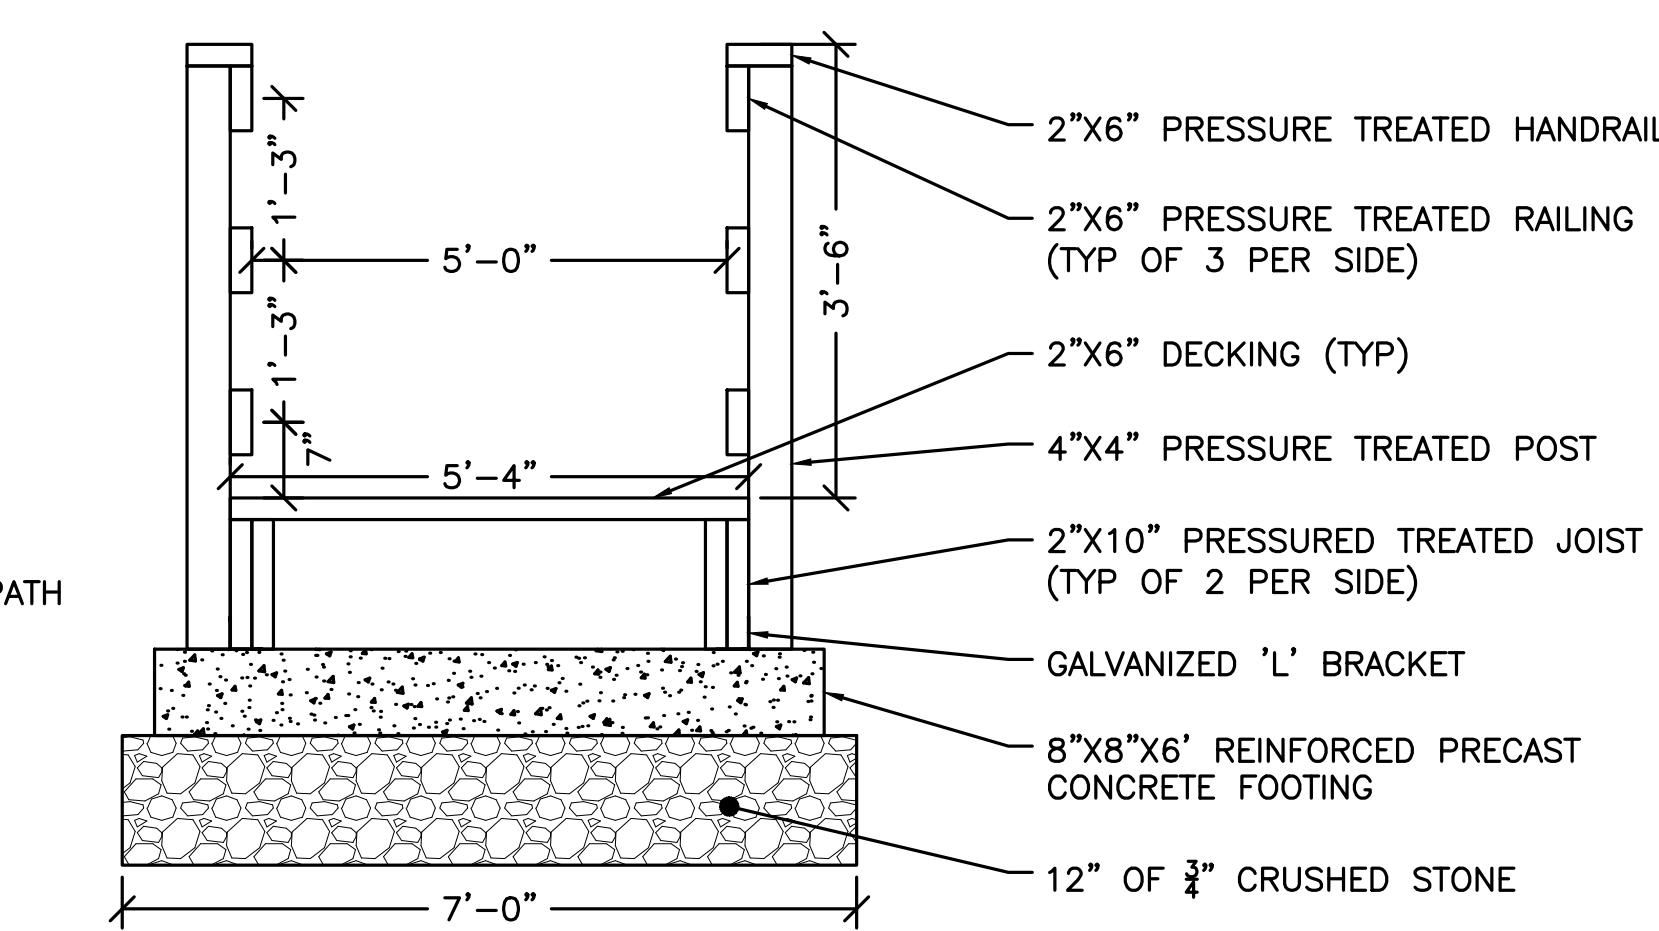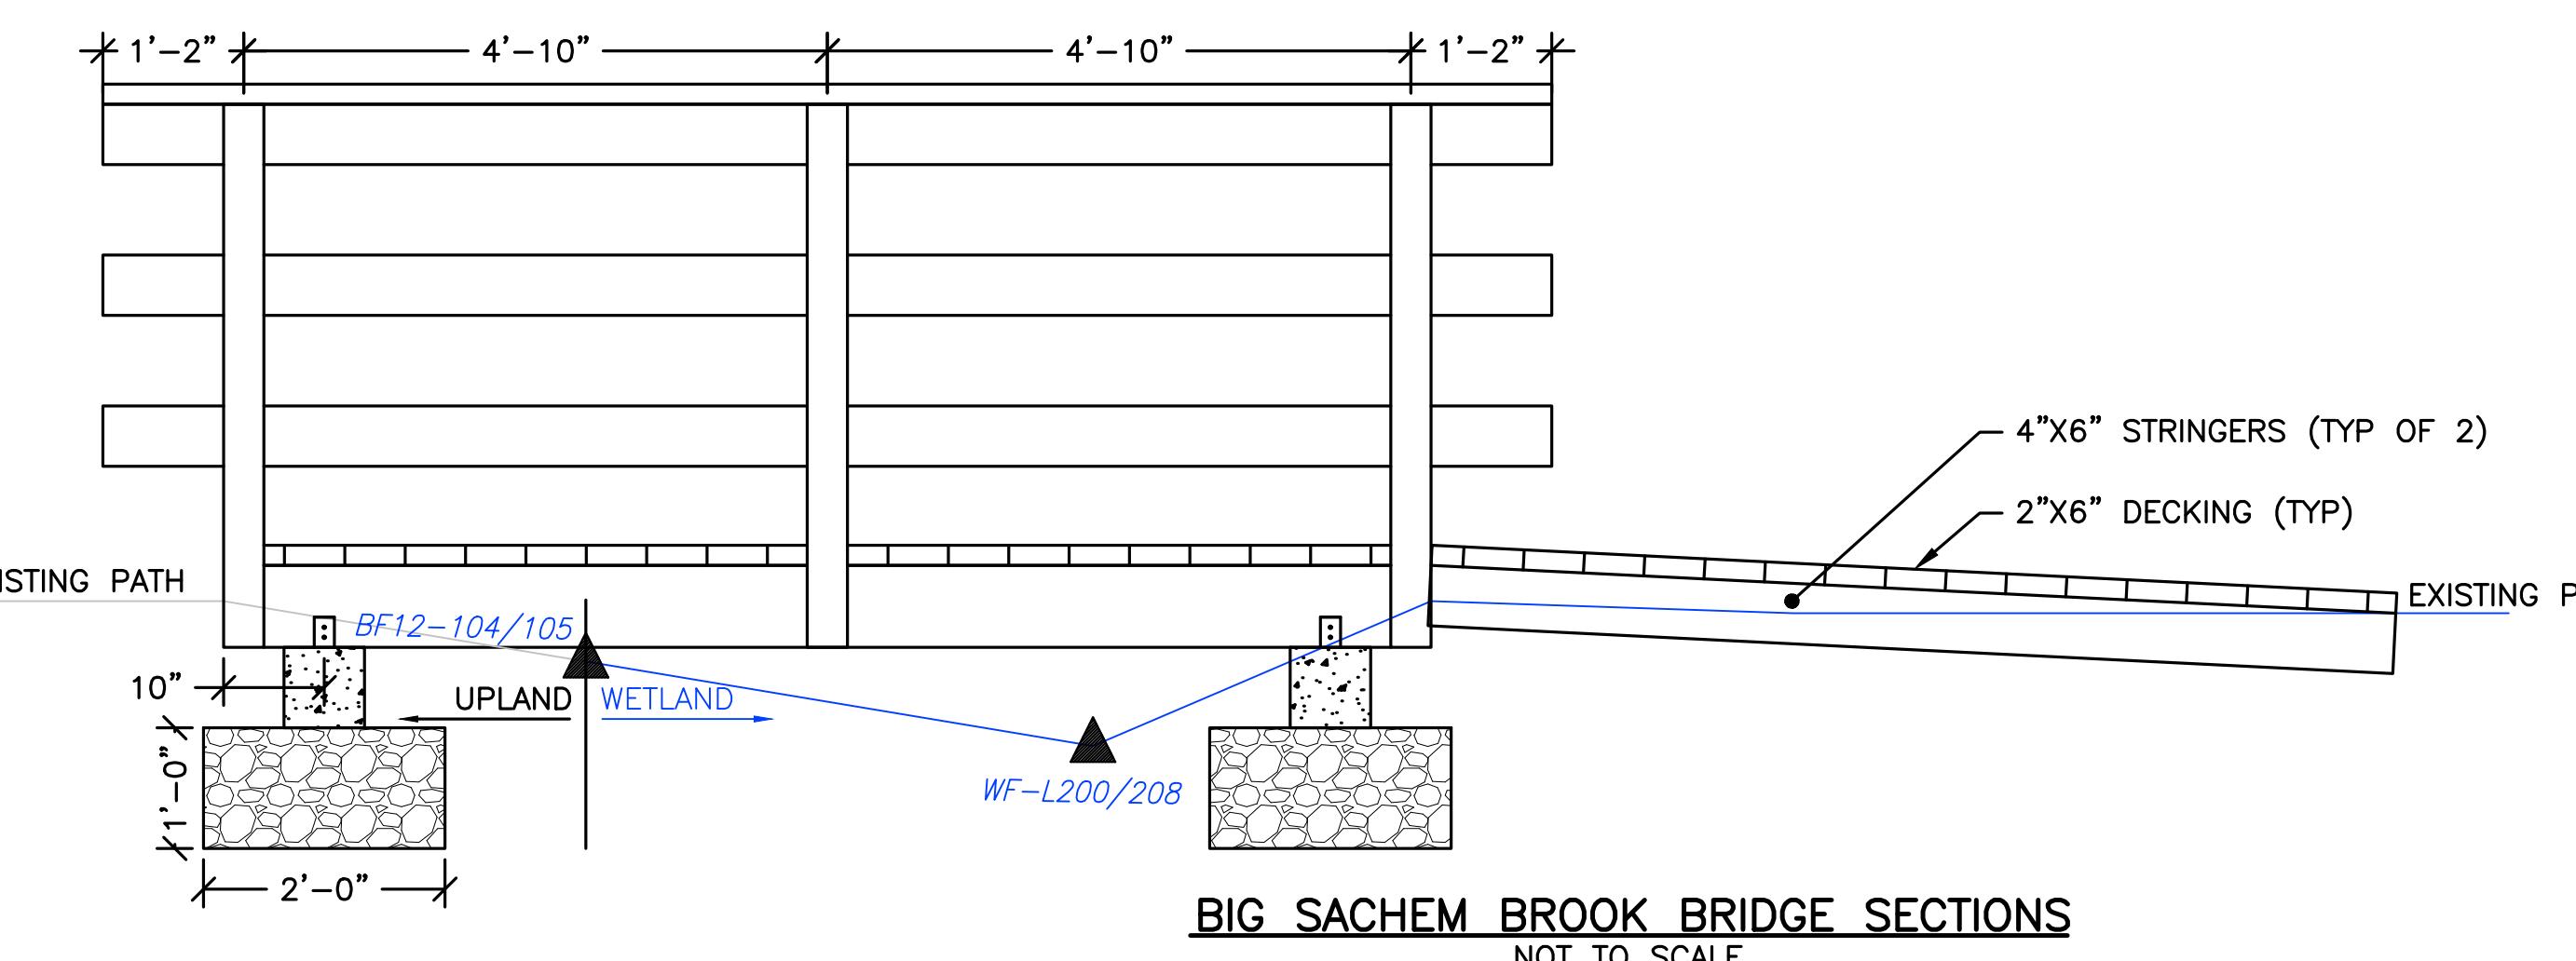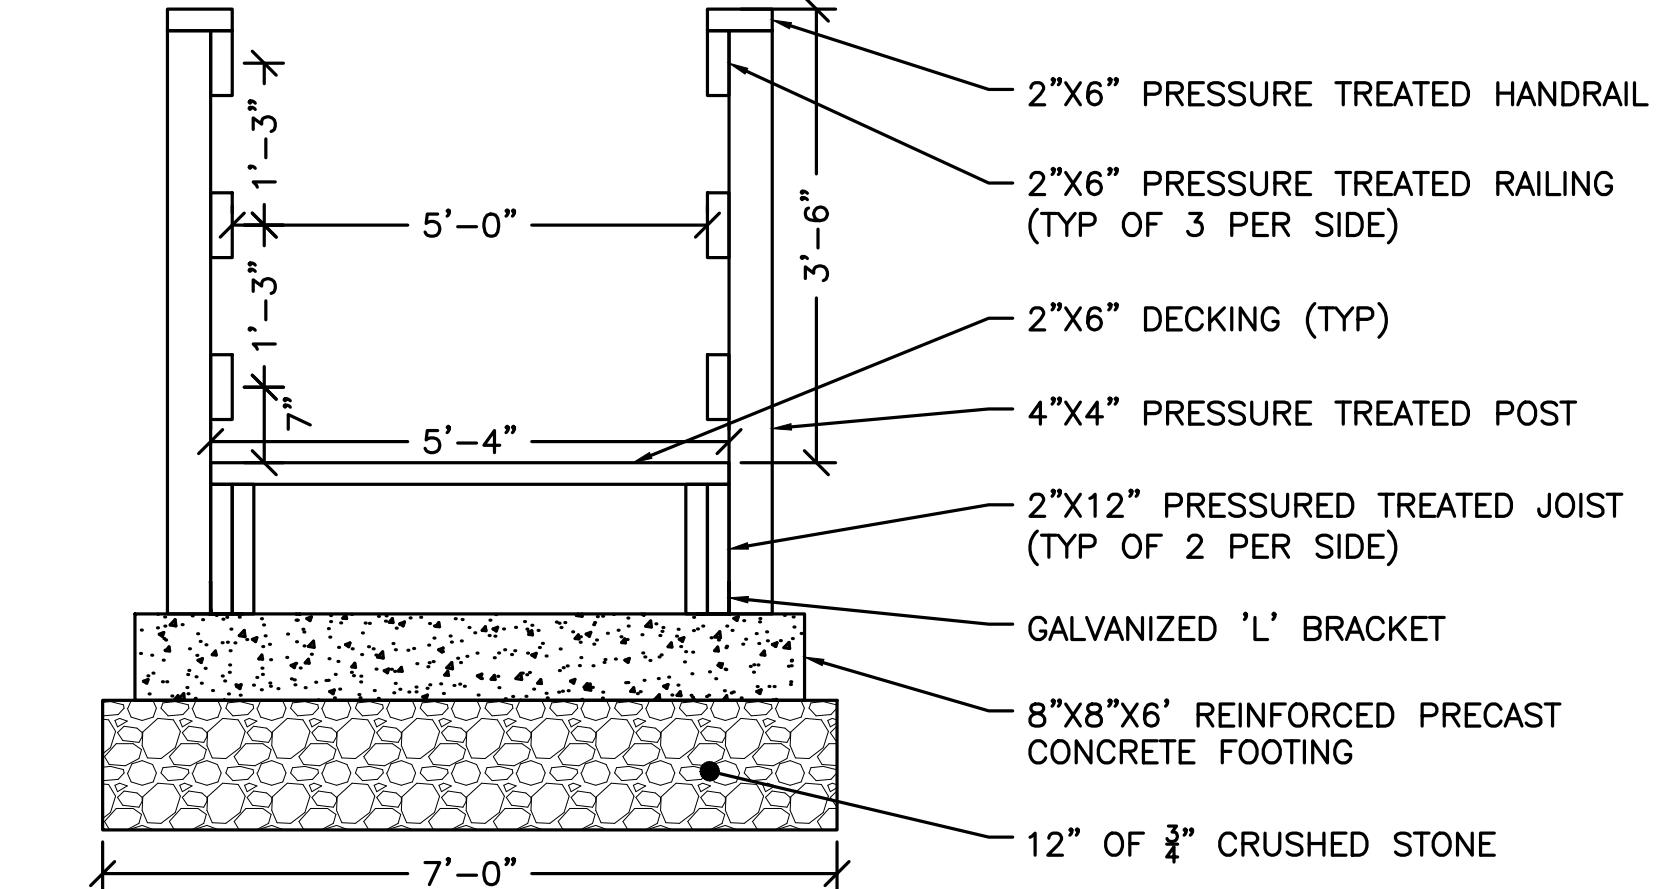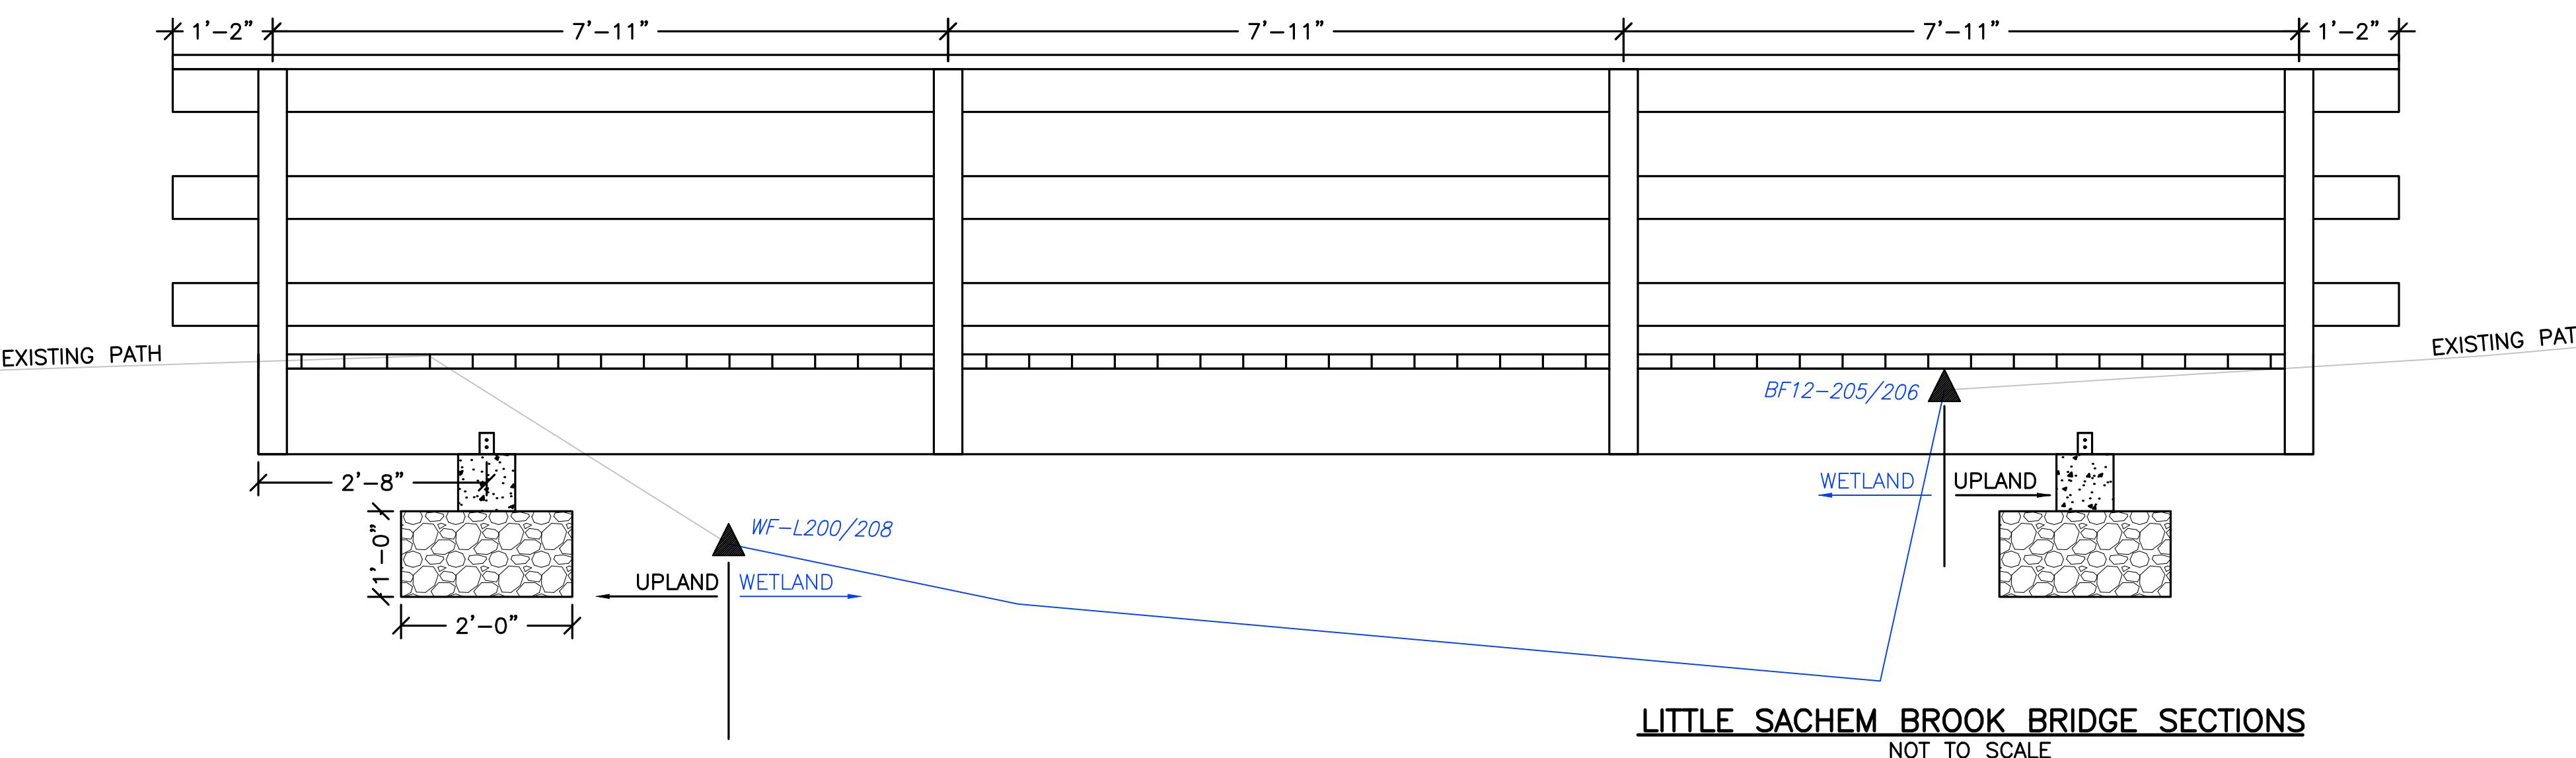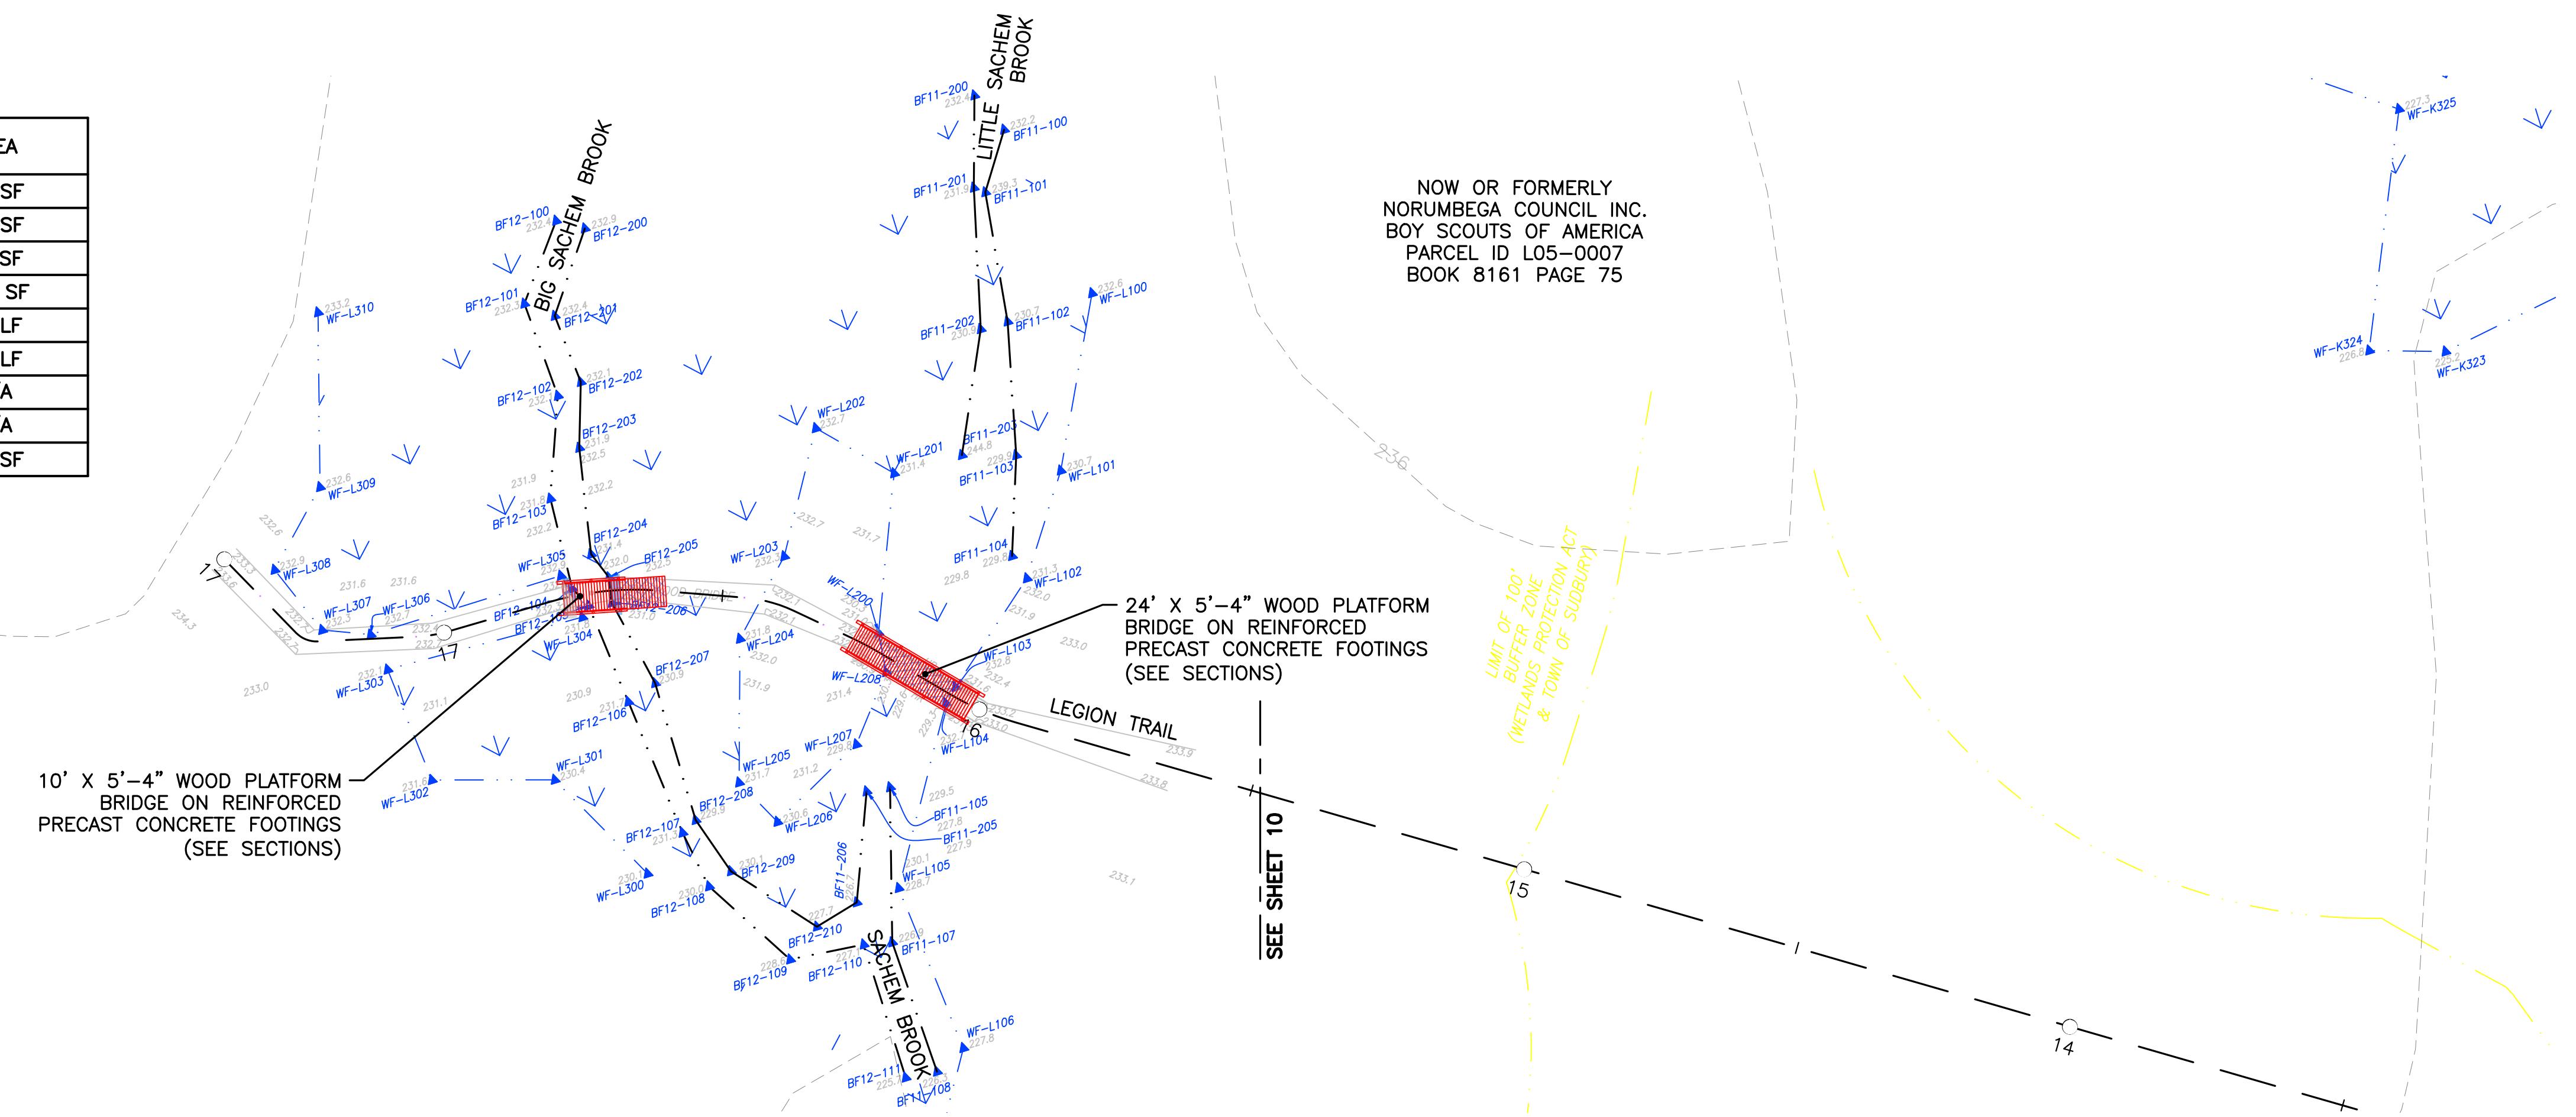

HOWARD STEIN HUDSON
11 Beacon Street, Suite 1010
Boston, MA 02108
www.hshassoc.com

NOBSCOT SCOUT RESERVATION PERMITTING & CONSTRUCTION PLANS						
HSH PROJECT NUMBER	DATE	DRAWN BY	CHKD. BY	APPRVD. BY	SHEET NO.	TOTAL SHEETS
2016033.02	11/21/22	JBC	JD	REL	11	22

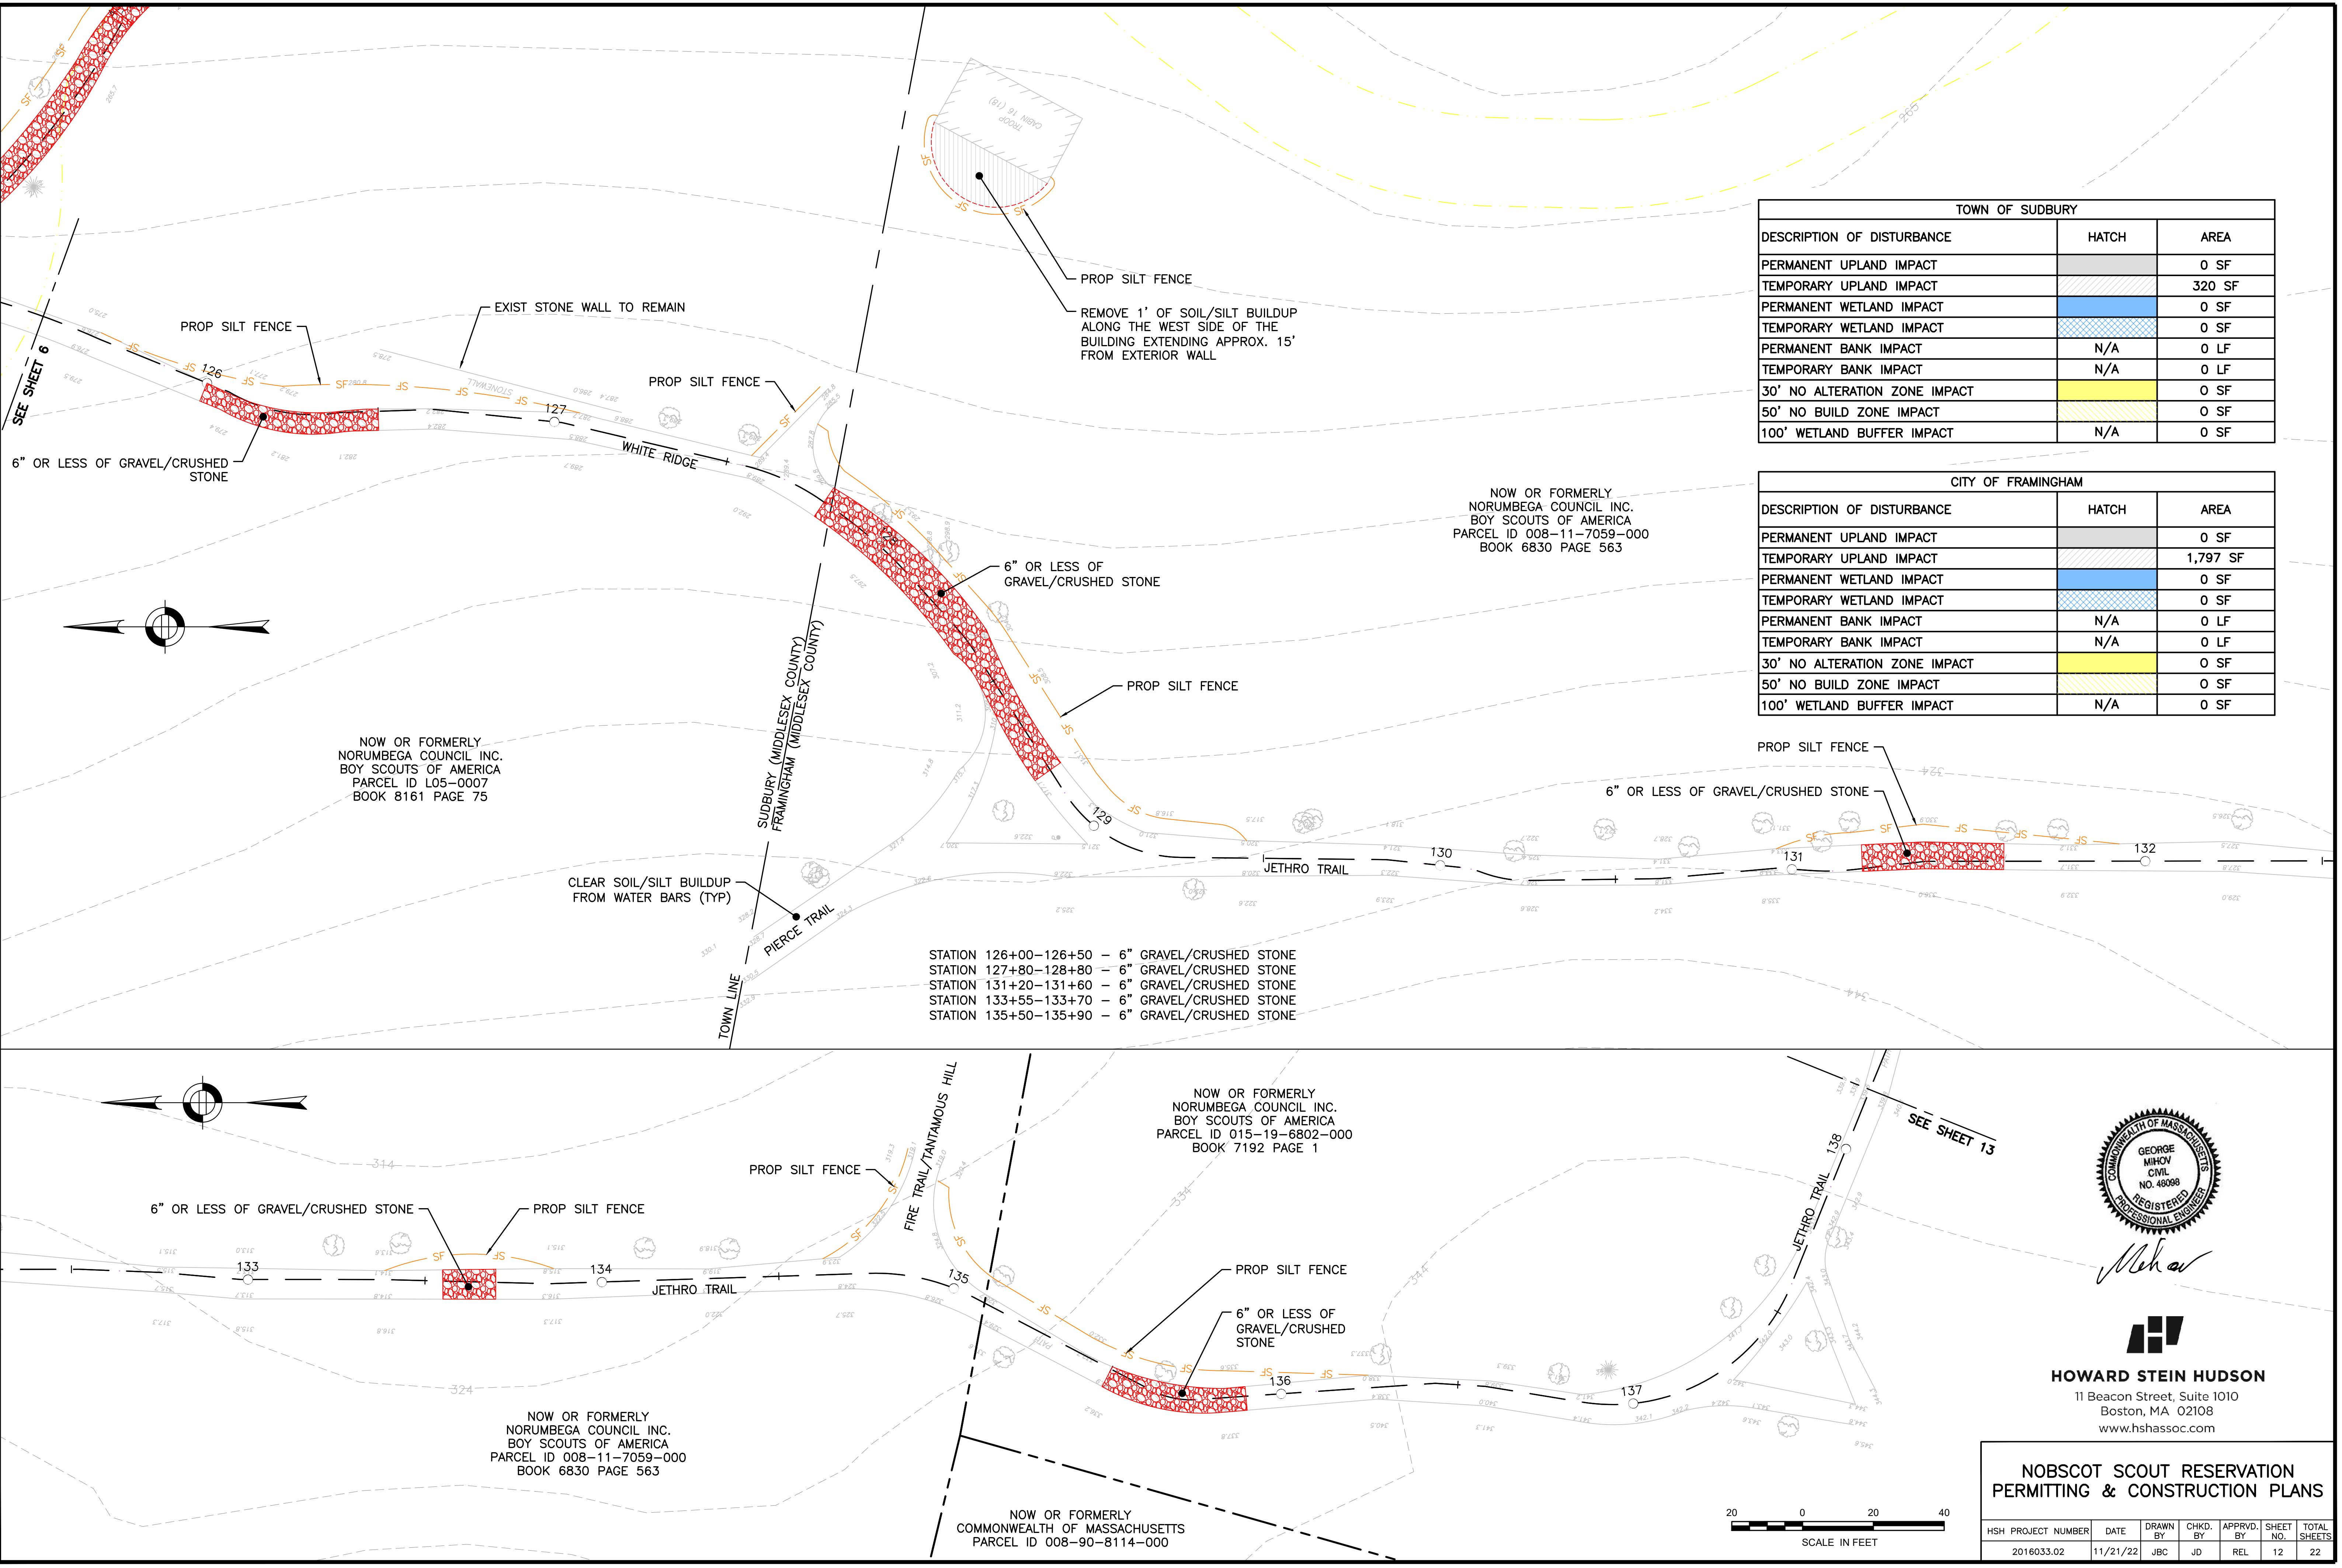

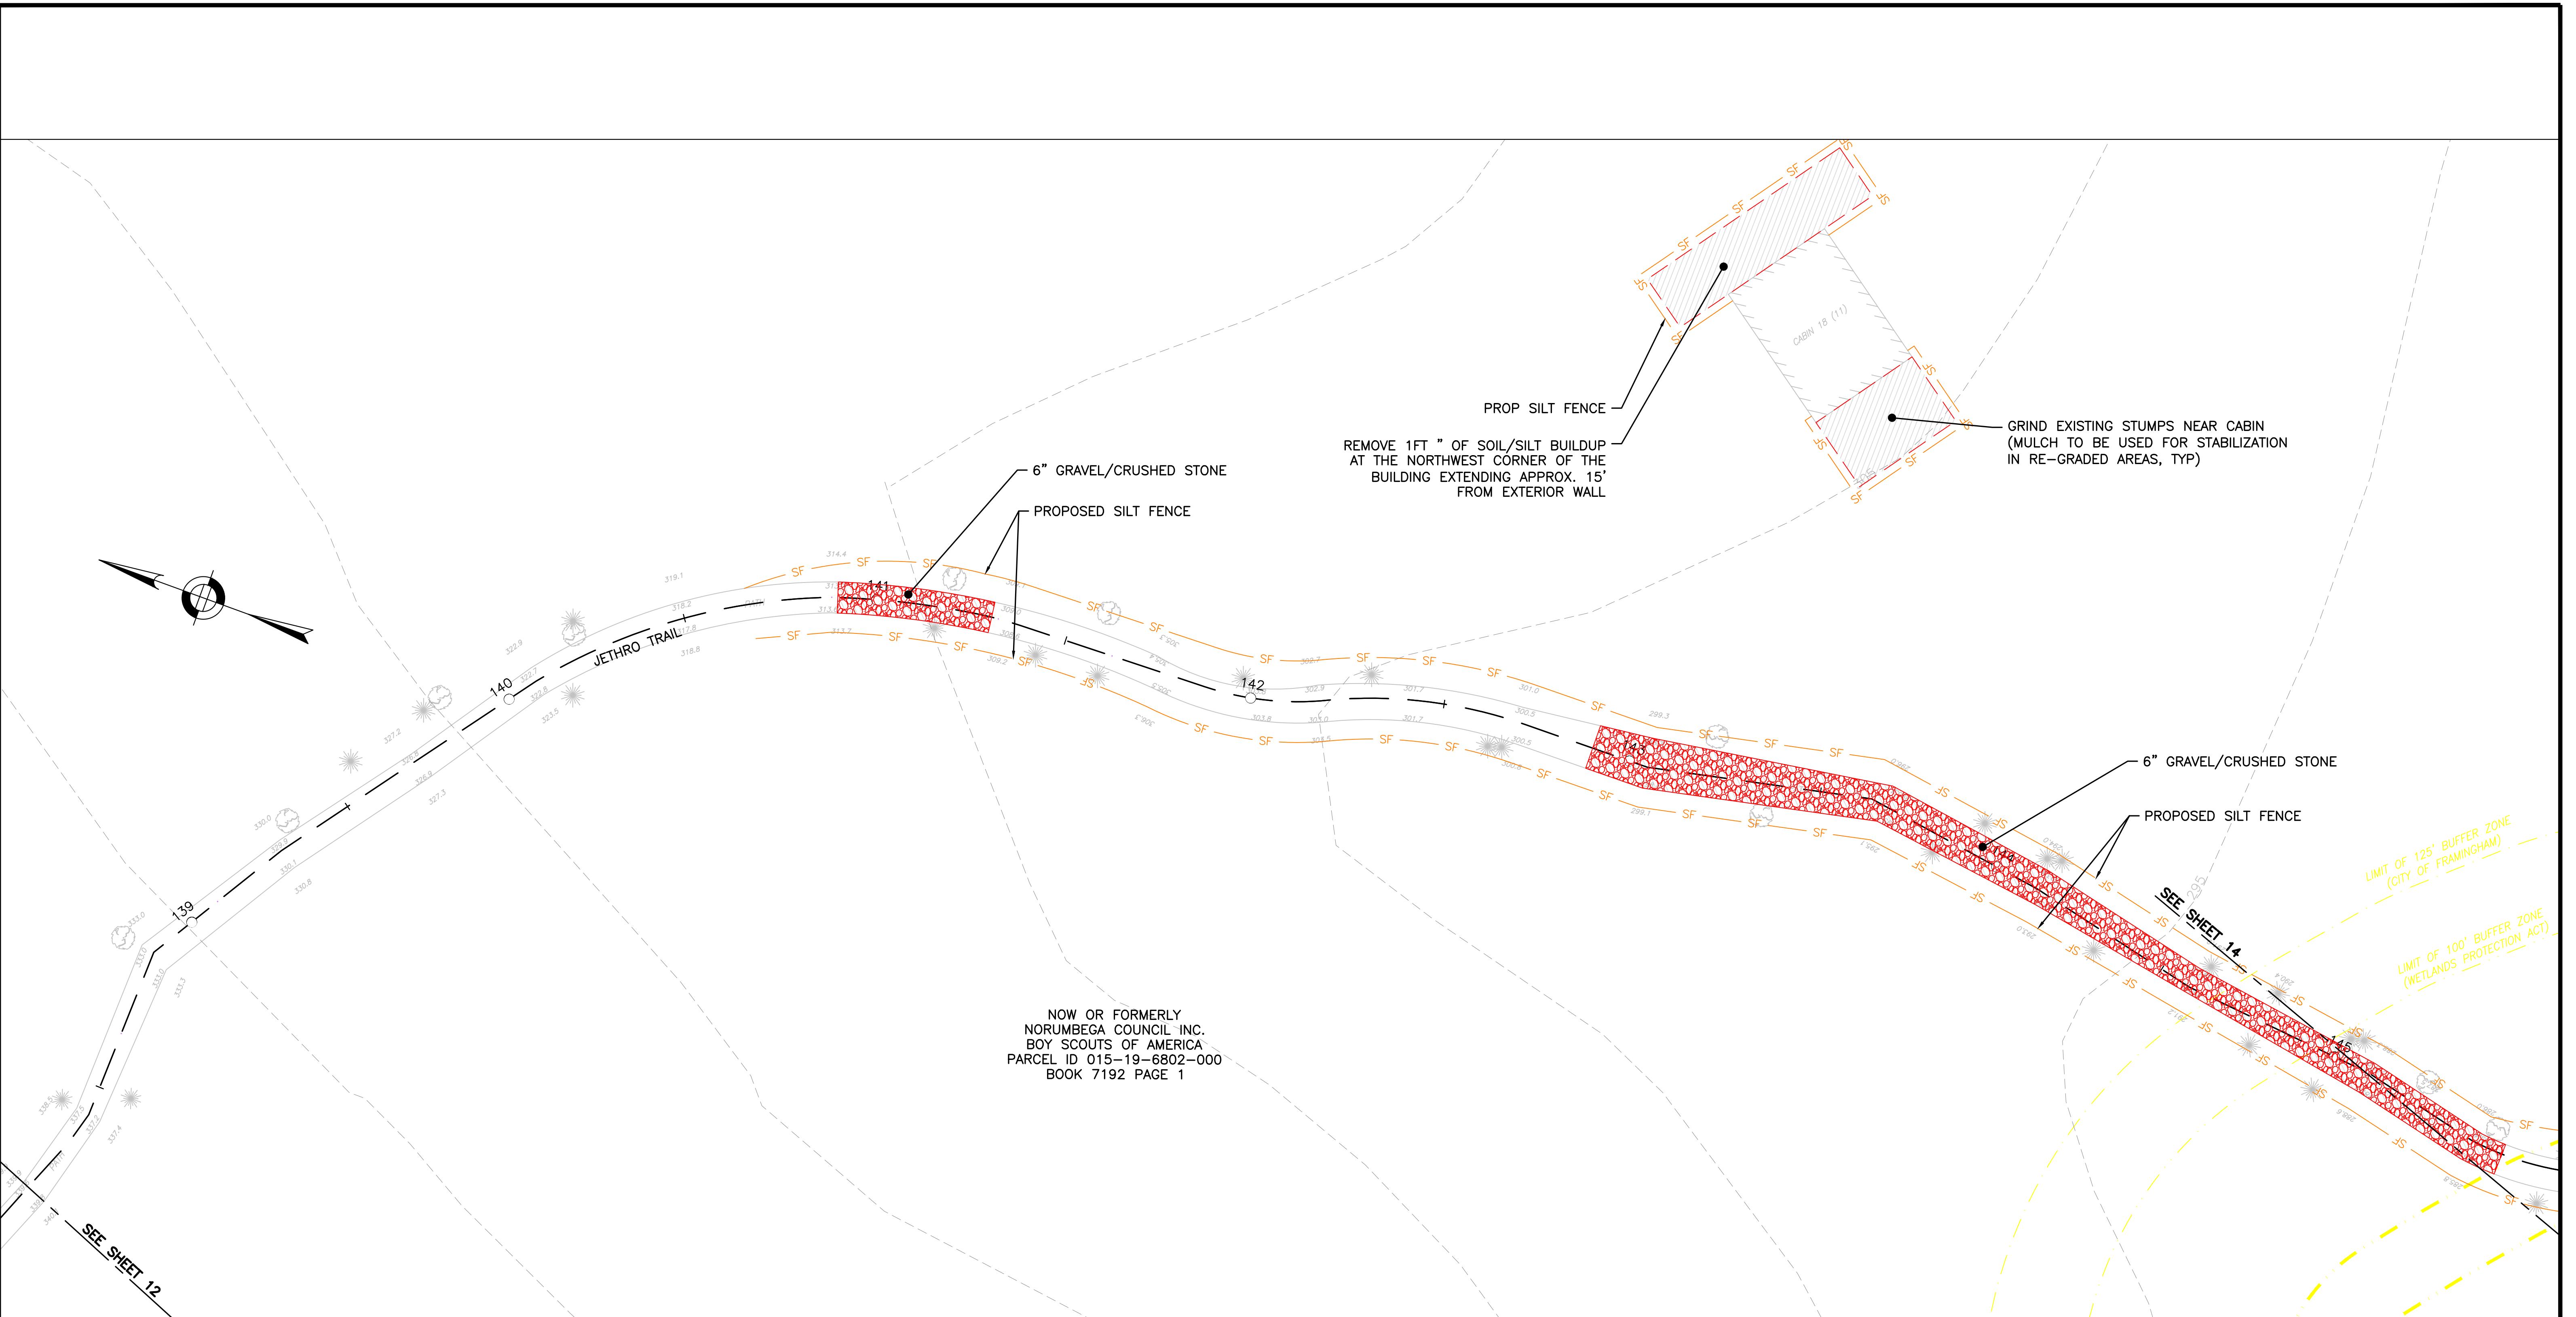

DESCRIPTION OF DISTURBANCE	HATCH	AREA
PERMANENT UPLAND IMPACT		0 SF
TEMPORARY UPLAND IMPACT		4,255 SF
PERMANENT WETLAND IMPACT		0 SF
TEMPORARY WETLAND IMPACT		0 SF
PERMANENT BANK IMPACT	N/A	0 LF
TEMPORARY BANK IMPACT	N/A	0 LF
30' NO ALTERATION ZONE IMPACT		0 SF
50' NO BUILD ZONE IMPACT		0 SF
100' WETLAND BUFFER IMPACT	N/A	462 SF

STATION 140+90-141+30 - 6" GRAVEL/CRUSHED STONE
STATION 142+90-145+50 - 6" GRAVEL/CRUSHED STONE




Mihov

20 0 20 40
SCALE IN FEET

HOWARD STEIN HUDSON
11 Beacon Street, Suite 1010
Boston, MA 02108
www.hshassoc.com

NOBSCOT SCOUT RESERVATION PERMITTING & CONSTRUCTION PLANS						
HSH PROJECT NUMBER	DATE	DRAWN BY	CHKD. BY	APPRVD. BY	HEET NO.	TOTAL SHEETS
2016033.02	11/21/22	JBC	JD	REL	13	22

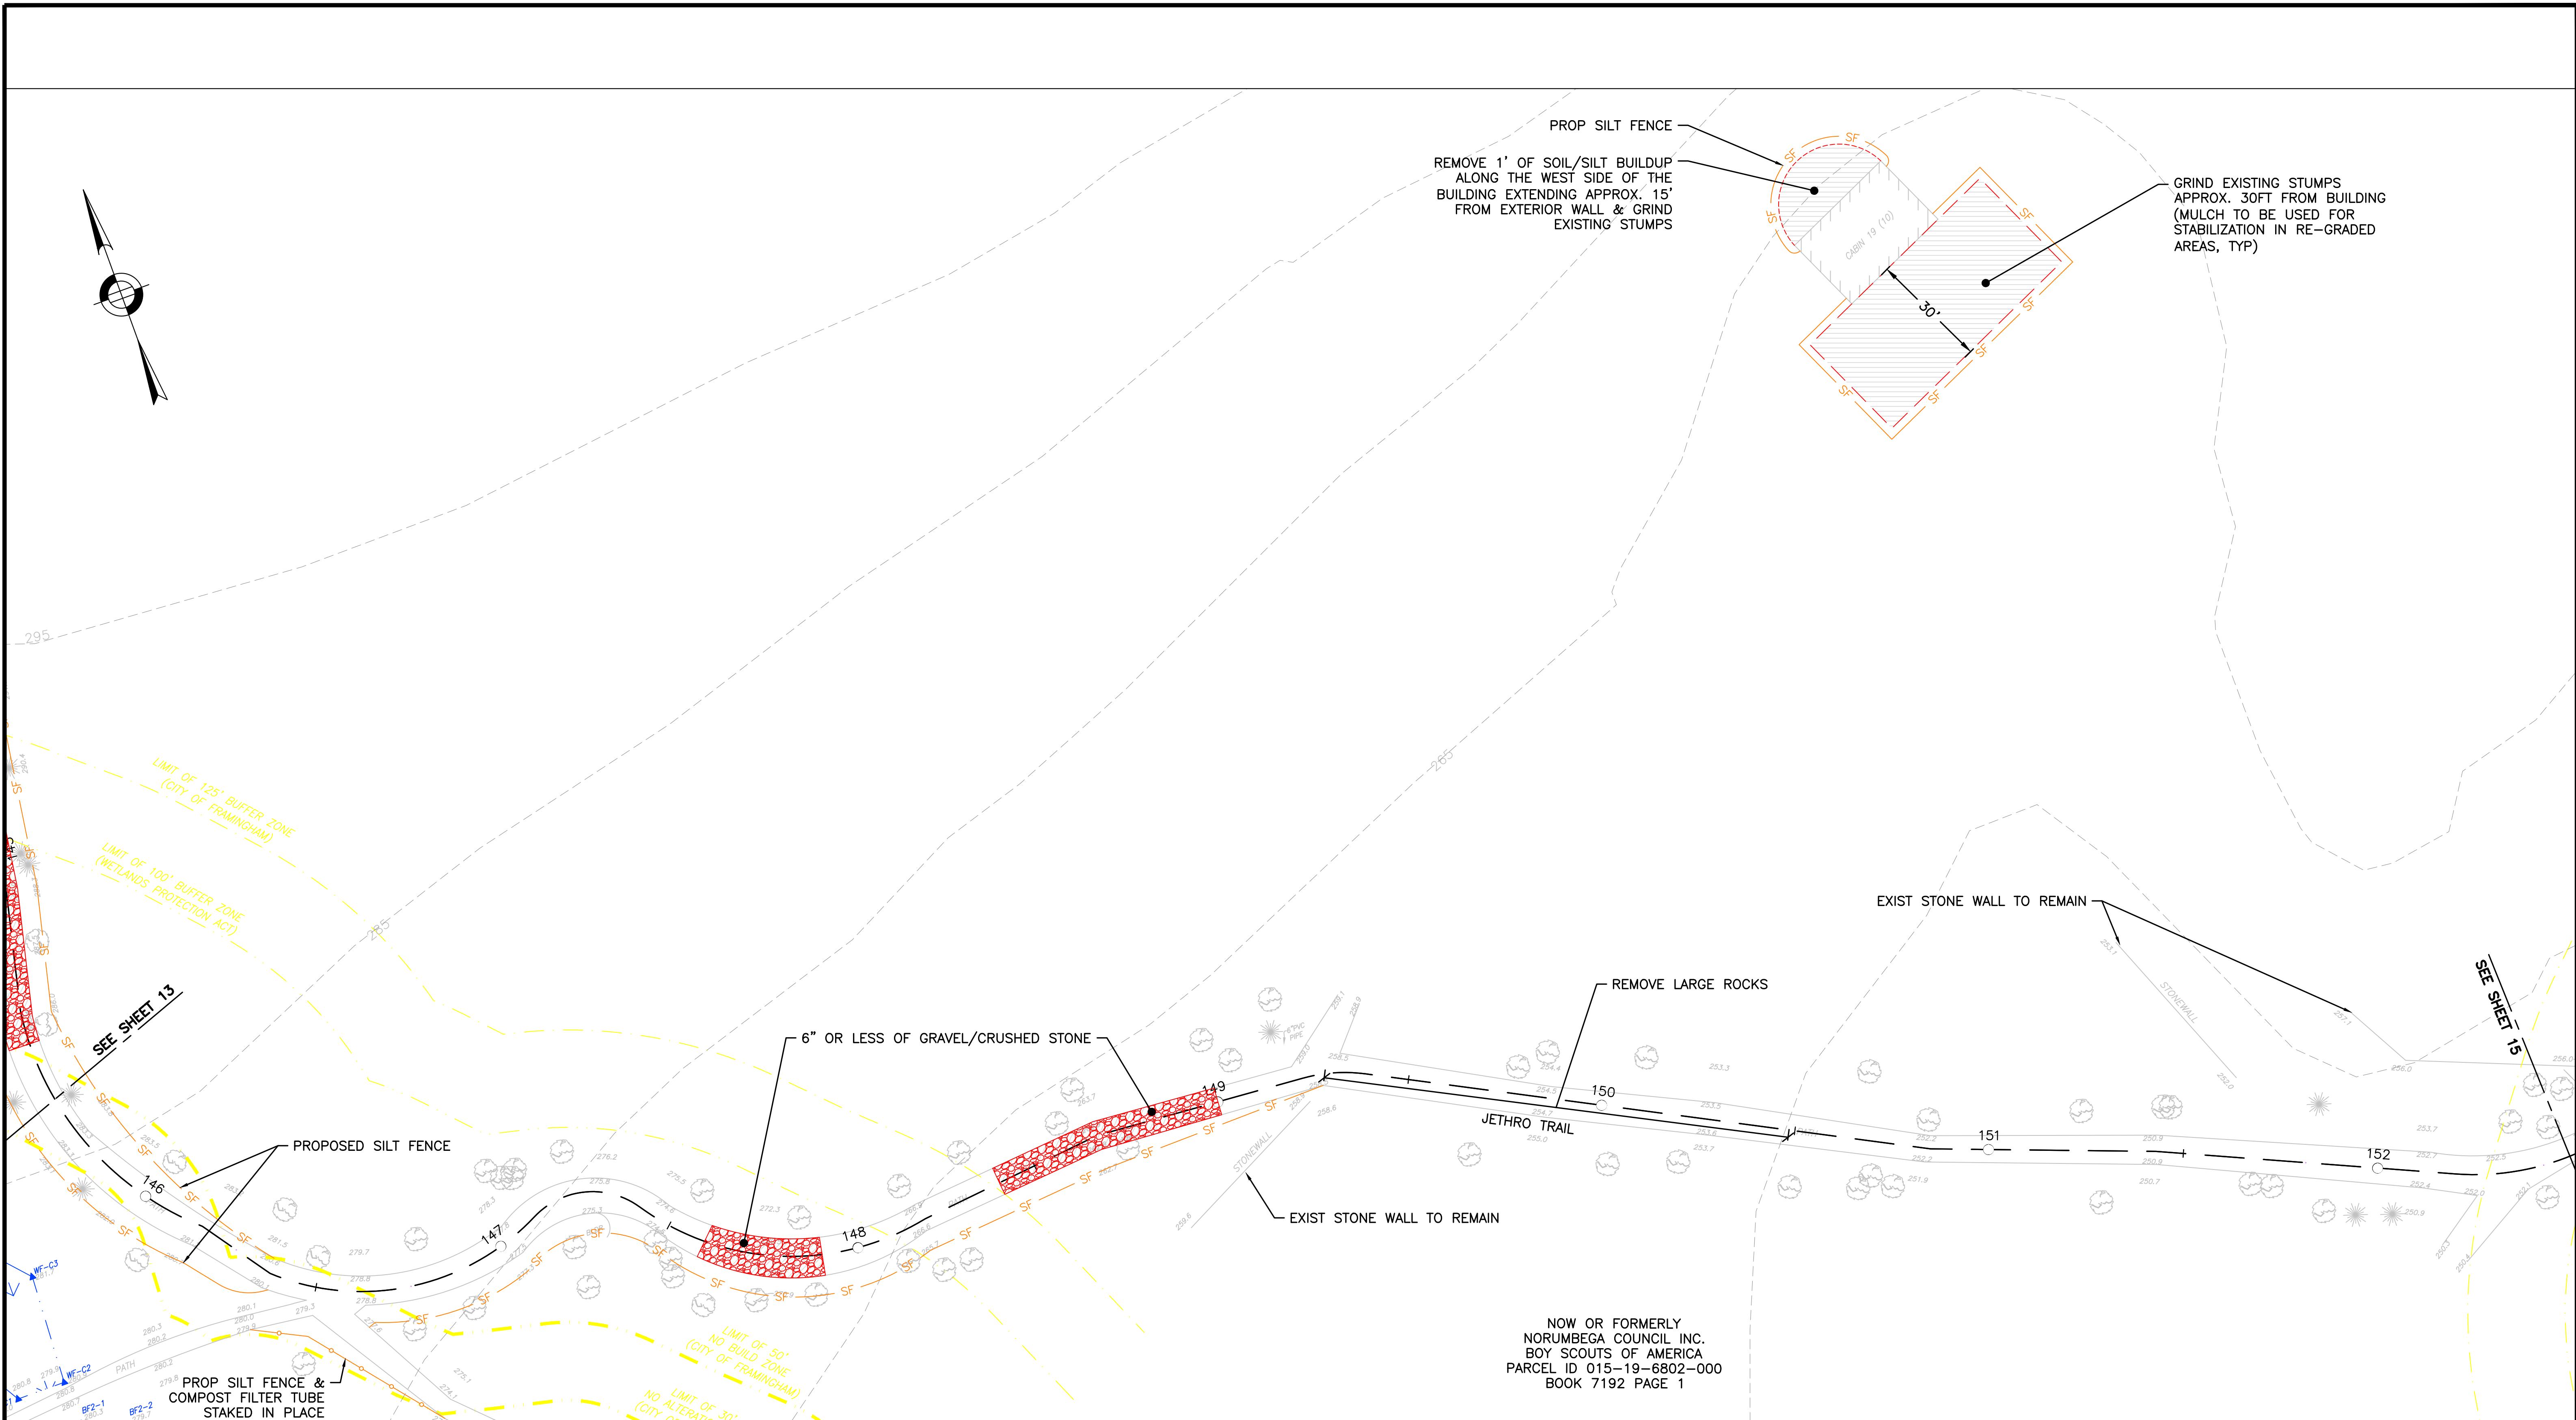

DESCRIPTION OF DISTURBANCE	HATCH	AREA
PERMANENT UPLAND IMPACT		0 SF
TEMPORARY UPLAND IMPACT	/	2,933 SF
PERMANENT WETLAND IMPACT		0 SF
TEMPORARY WETLAND IMPACT	+	0 SF
PERMANENT BANK IMPACT	N/A	0 LF
TEMPORARY BANK IMPACT	N/A	0 LF
30' NO ALTERATION ZONE IMPACT		0 SF
50' NO BUILD ZONE IMPACT	/	0 SF
100' WETLAND BUFFER IMPACT	N/A	300 SF

STATION 147+60-147+90 - 6" GRAVEL/CRUSHED STO
STATION 148+40-149+00 - 6" GRAVEL/CRUSHED STO
STATION 149+30-150+50 - REMOVE LARGE ROCKS



Mehar




HOWARD STEIN HUDSON

11 Beacon Street, Suite 1010
Boston, MA 02108
www.hshassoc.com

NOBSCOT SCOUT RESERVATION PERMITTING & CONSTRUCTION PLANS

HSH PROJECT NUMBER	DATE	DRAWN BY	CHKD. BY	APPRVD. BY	SHEET NO.	TOTAL SHEETS
2016033.02	11/21/22	JBC	JD	REL	14	22

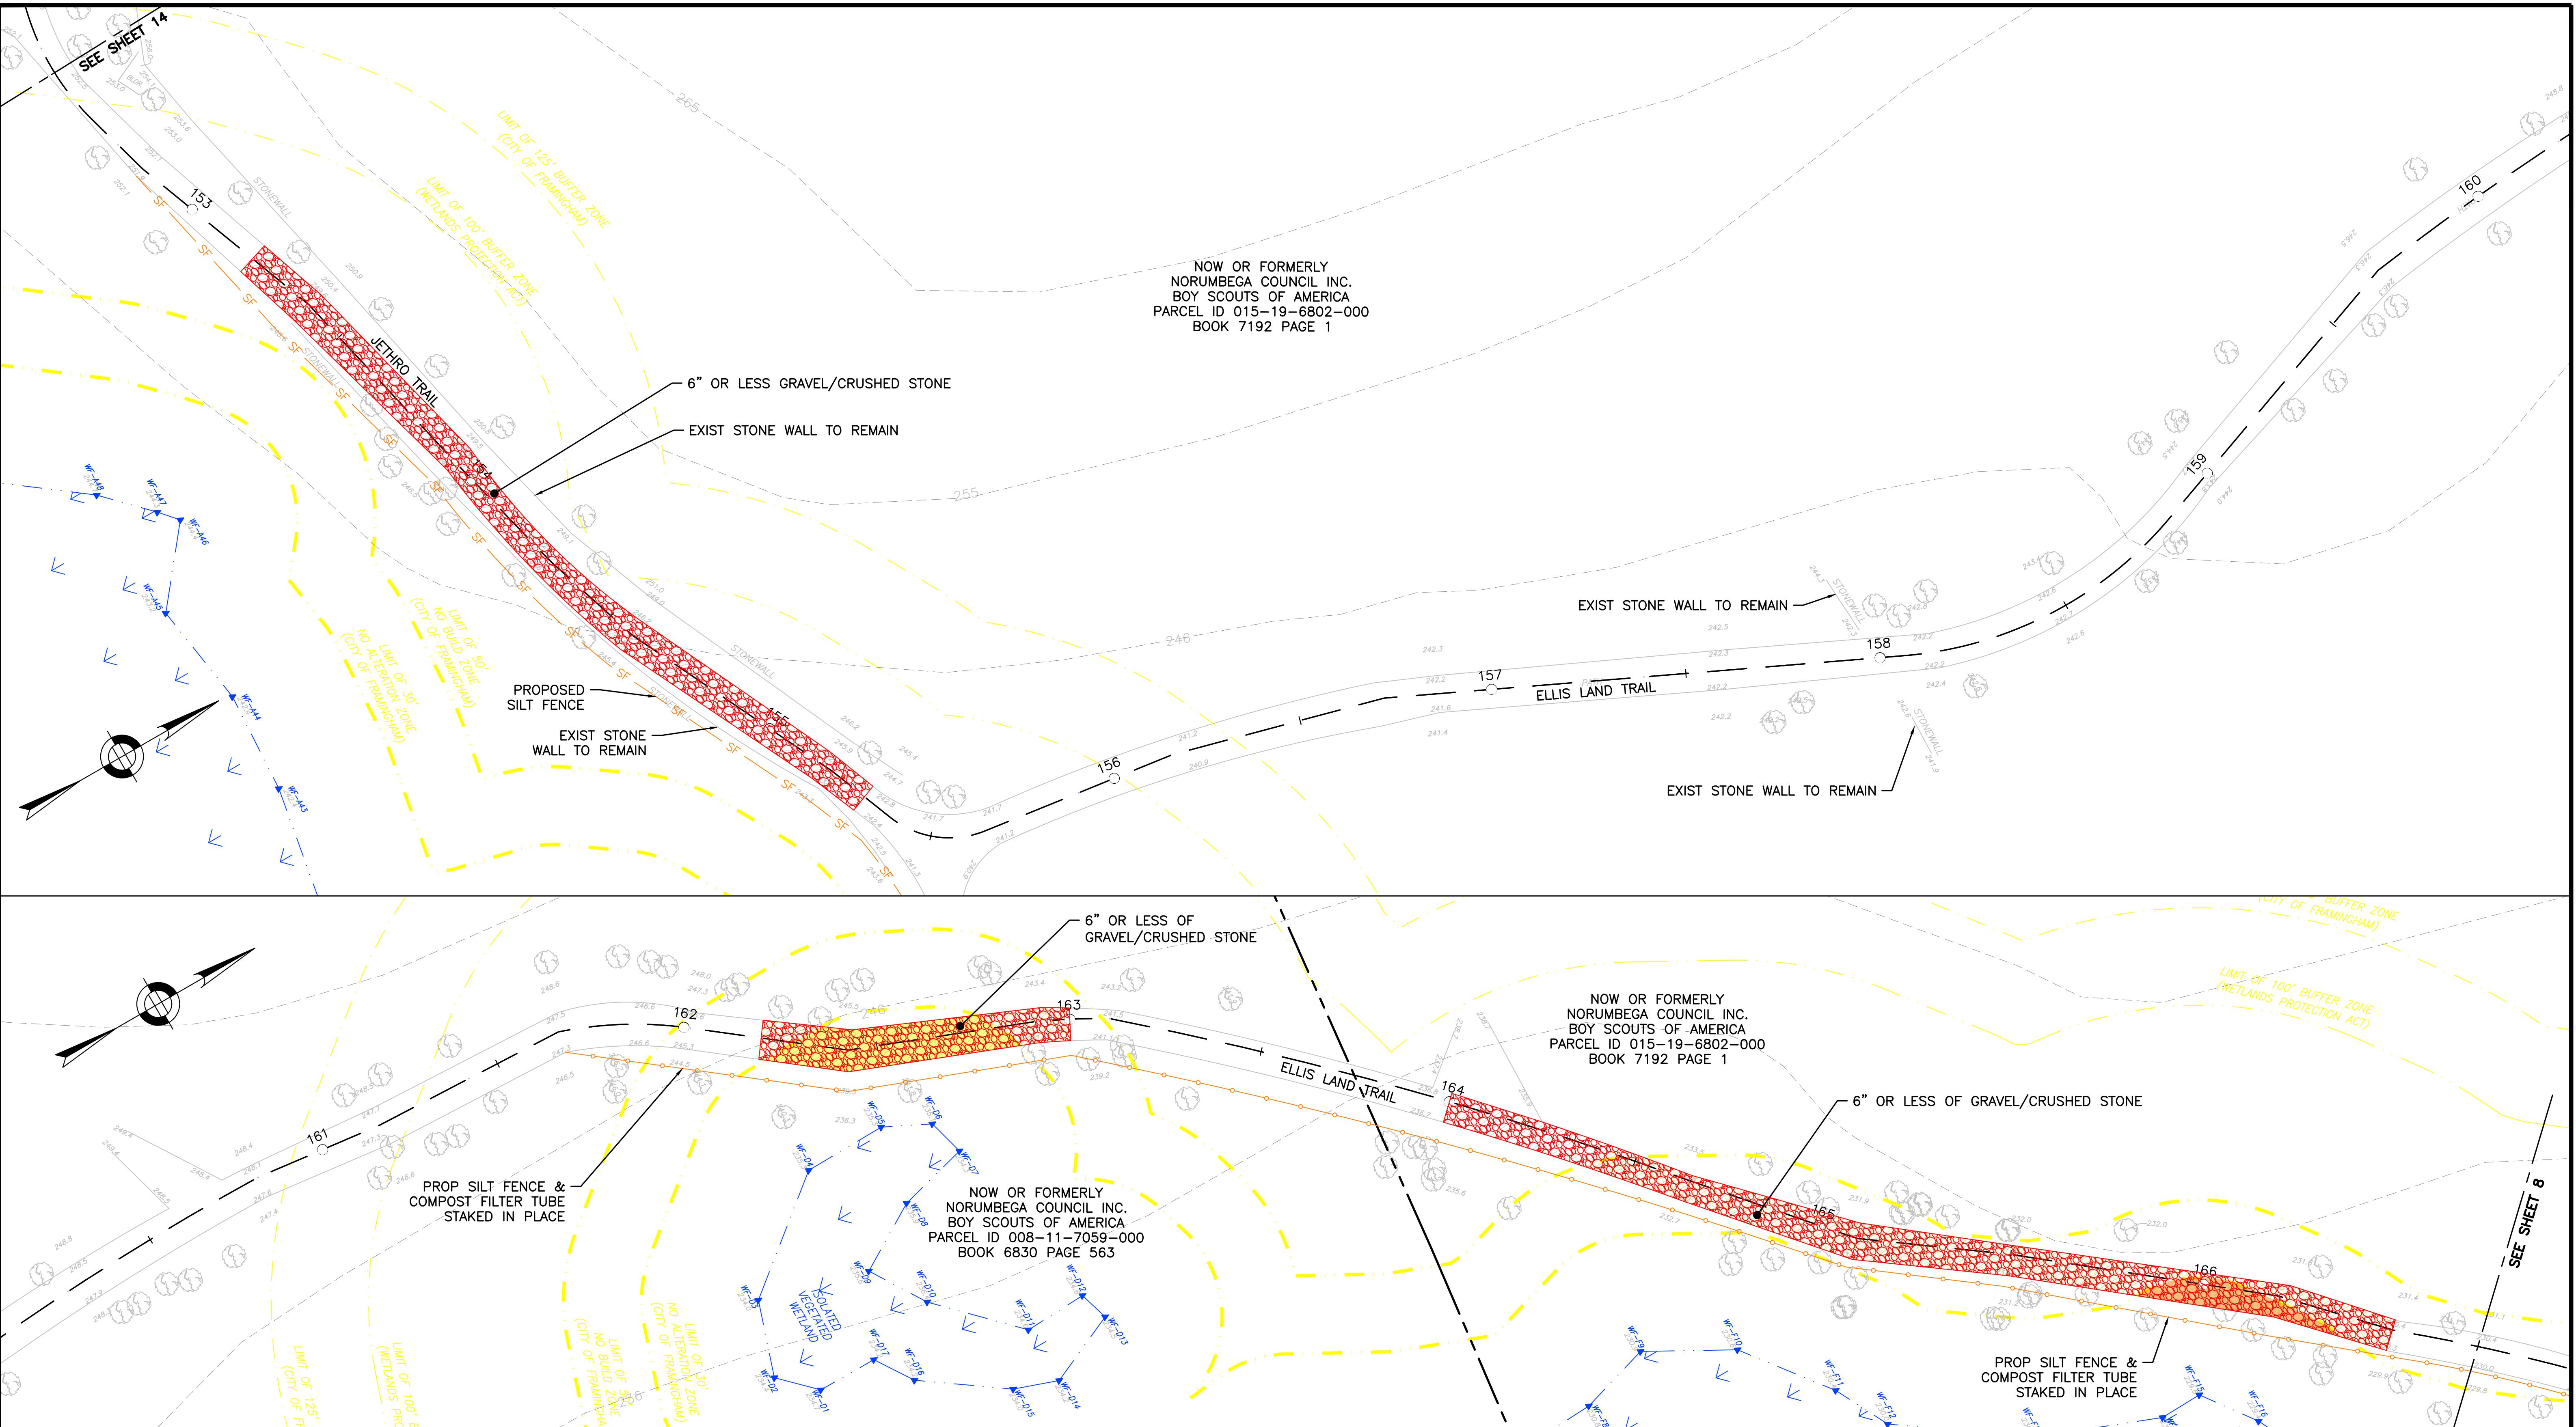

DESCRIPTION OF DISTURBANCE	HATCH	AREA
PERMANENT UPLAND IMPACT		0 SF
TEMPORARY UPLAND IMPACT	/	4,591 SF
PERMANENT WETLAND IMPACT		0 SF
TEMPORARY WETLAND IMPACT	+	0 SF
PERMANENT BANK IMPACT	N/A	0 LF
TEMPORARY BANK IMPACT	N/A	0 LF
30' NO ALTERATION ZONE IMPACT		782 SF
50' NO BUILD ZONE IMPACT	/	1,950 SF
100' WETLAND BUFFER IMPACT	N/A	4,591 SF

STATION 153+20-155+30 - 6" GRAVEL/CRUSHED ST
STATION 162+20-163+00 - 6" GRAVEL/CRUSHED ST
STATION 164+00-166+50 - 6" GRAVEL/CRUSHED ST





Mehar


HOWARD STEIN HUDSON


11 Beacon Street, Suite 1010
Boston, MA 02108
www.hshassoc.com

NOBSCOT SCOUT RESERVATION PERMITTING & CONSTRUCTION PLANS



HSH PROJECT NUMBER	DATE	DRAWN BY	CHKD. BY	APPRVD. BY	SHEET NO.	TOTAL SHEETS
2016033.02	11/21/22	JBC	JD	REL	15	22

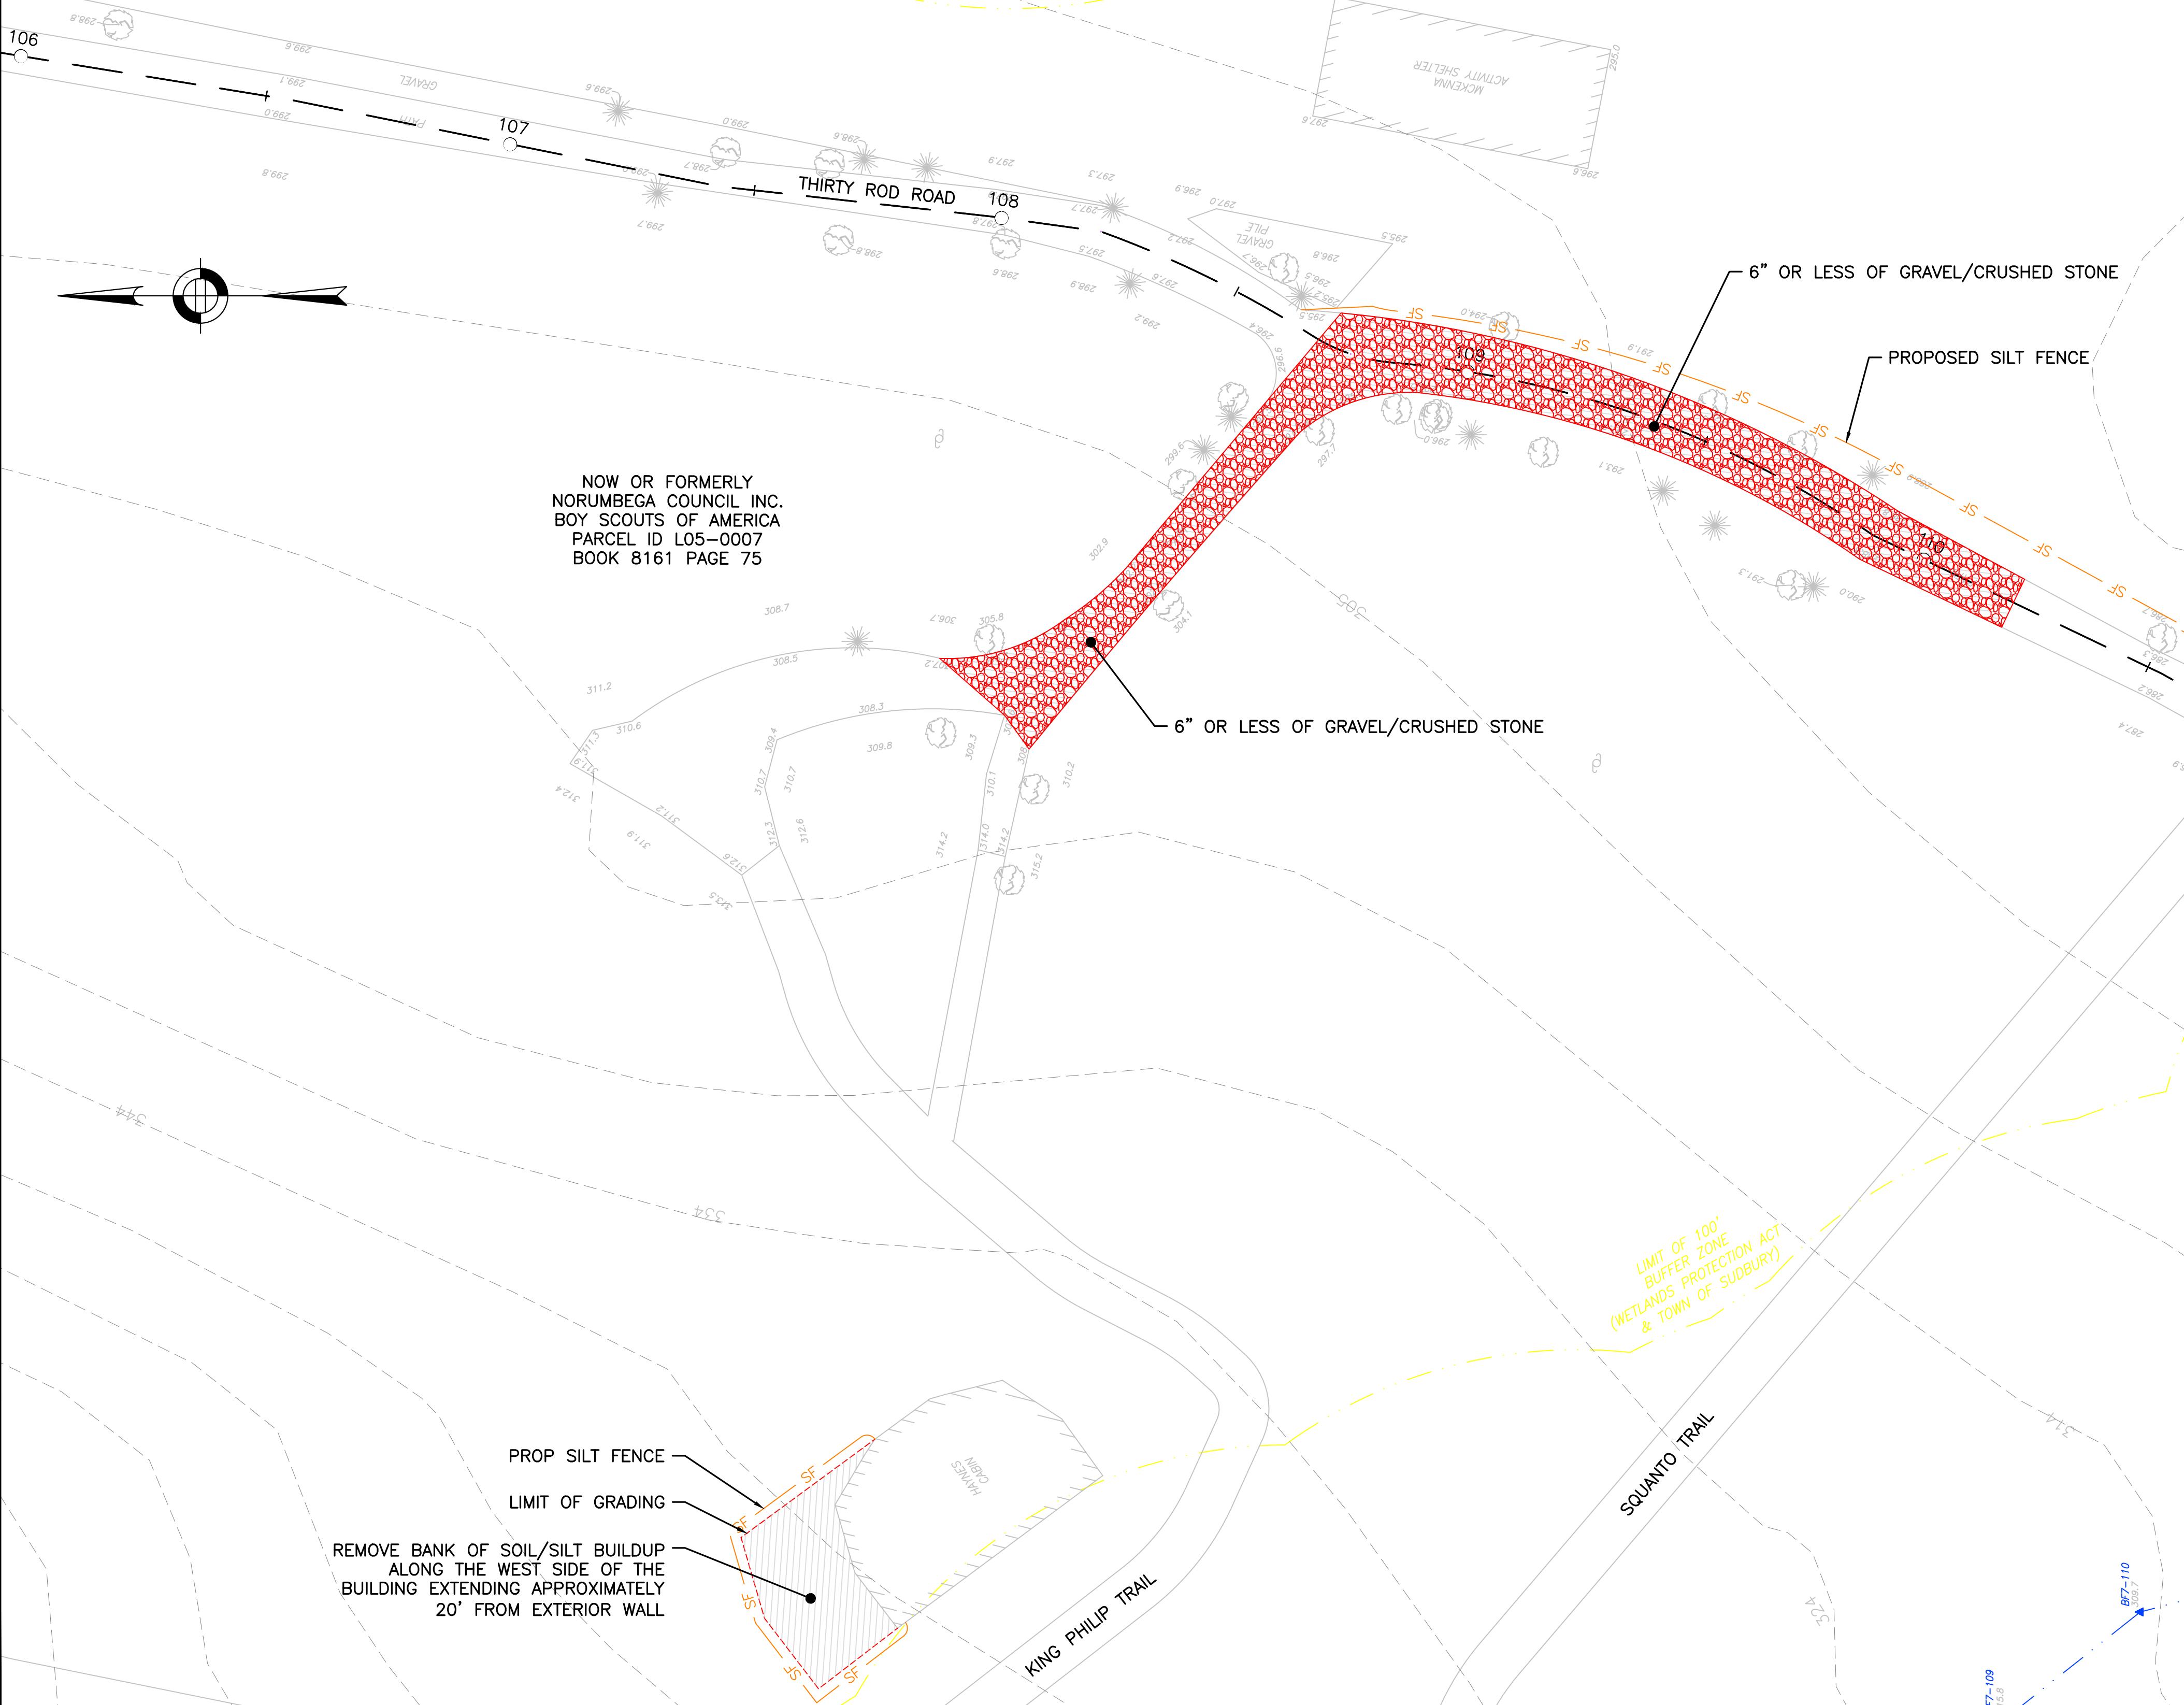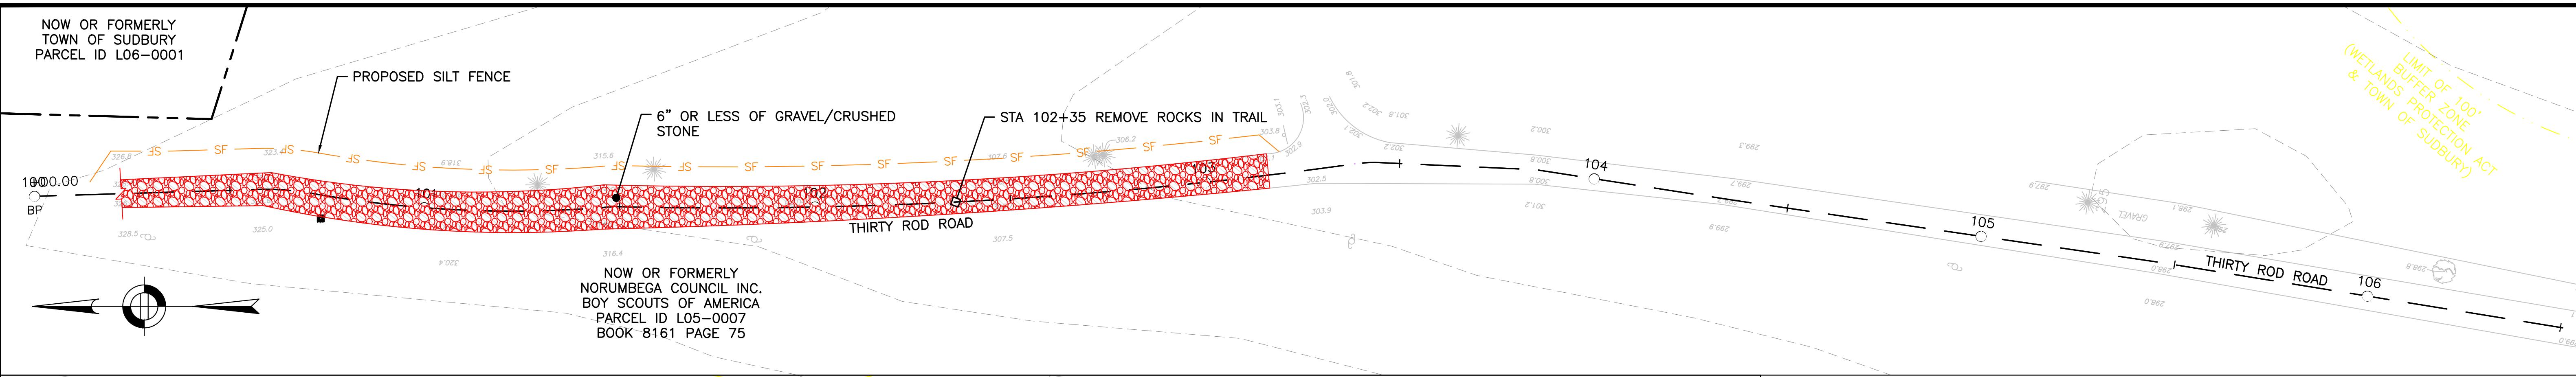

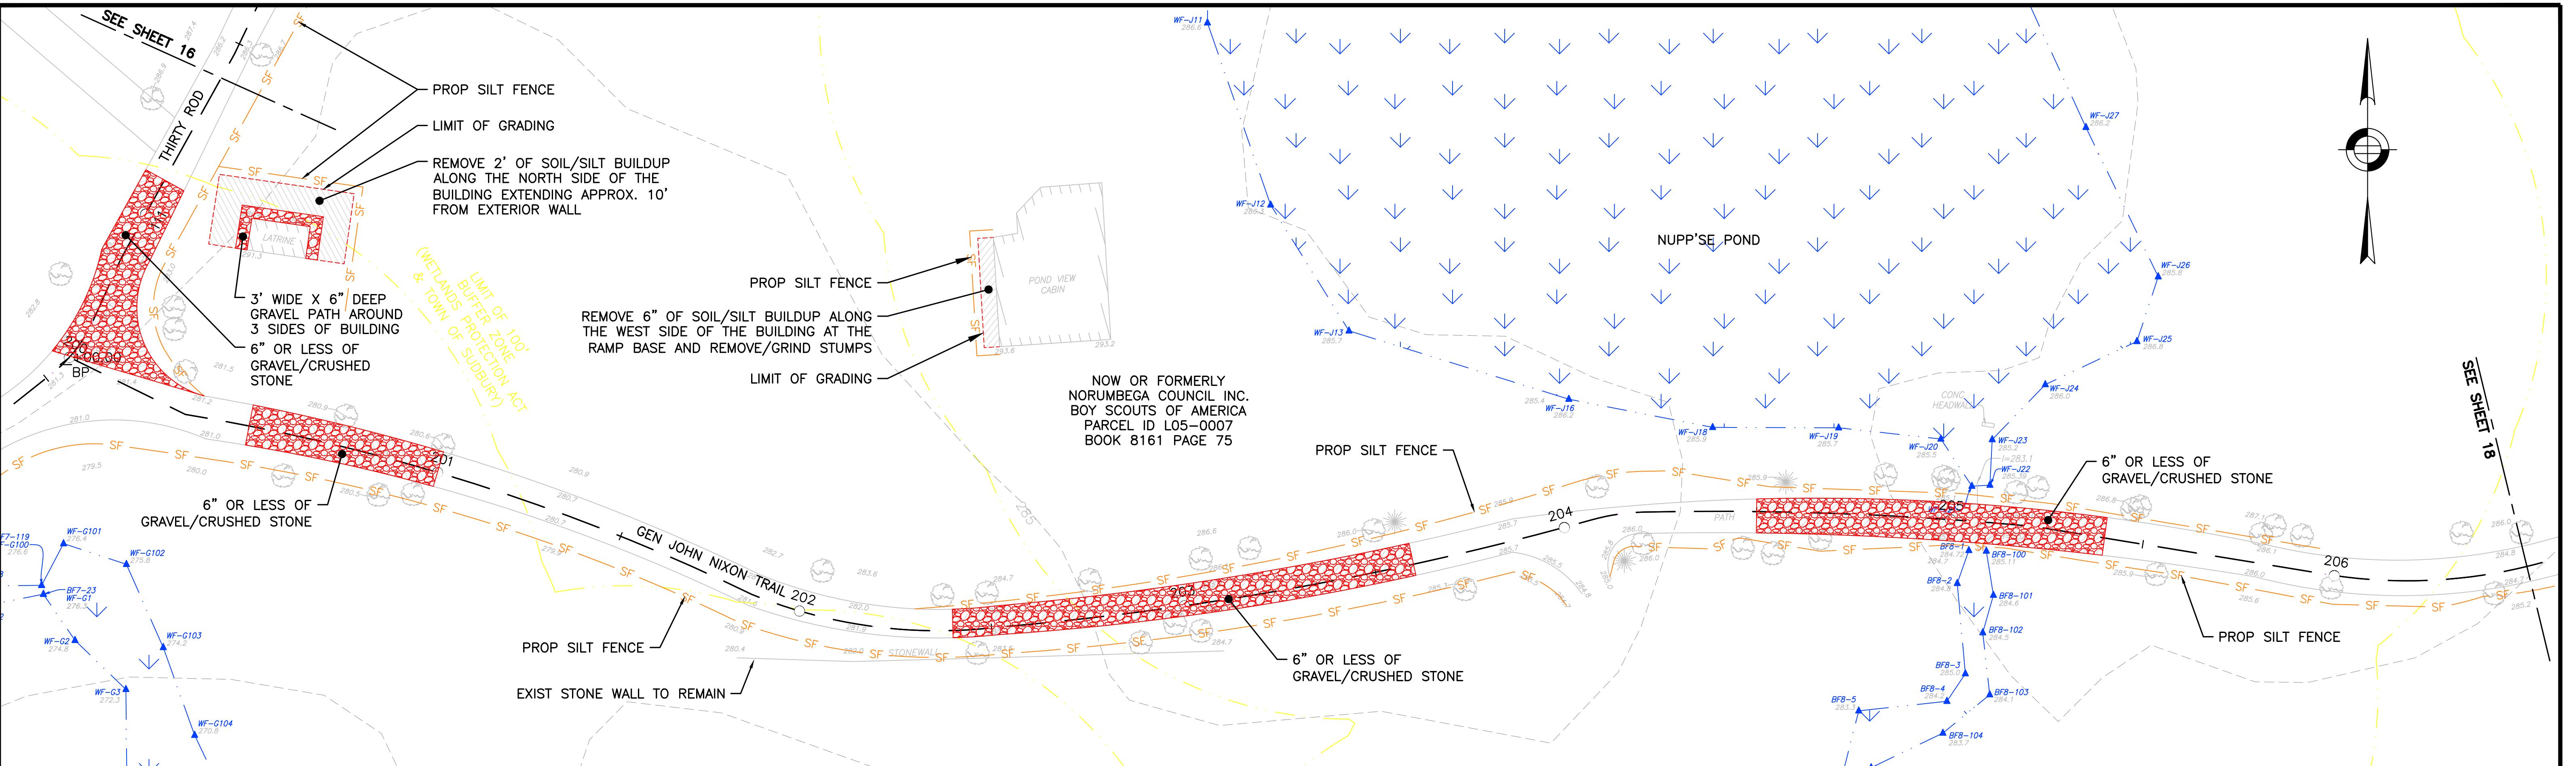

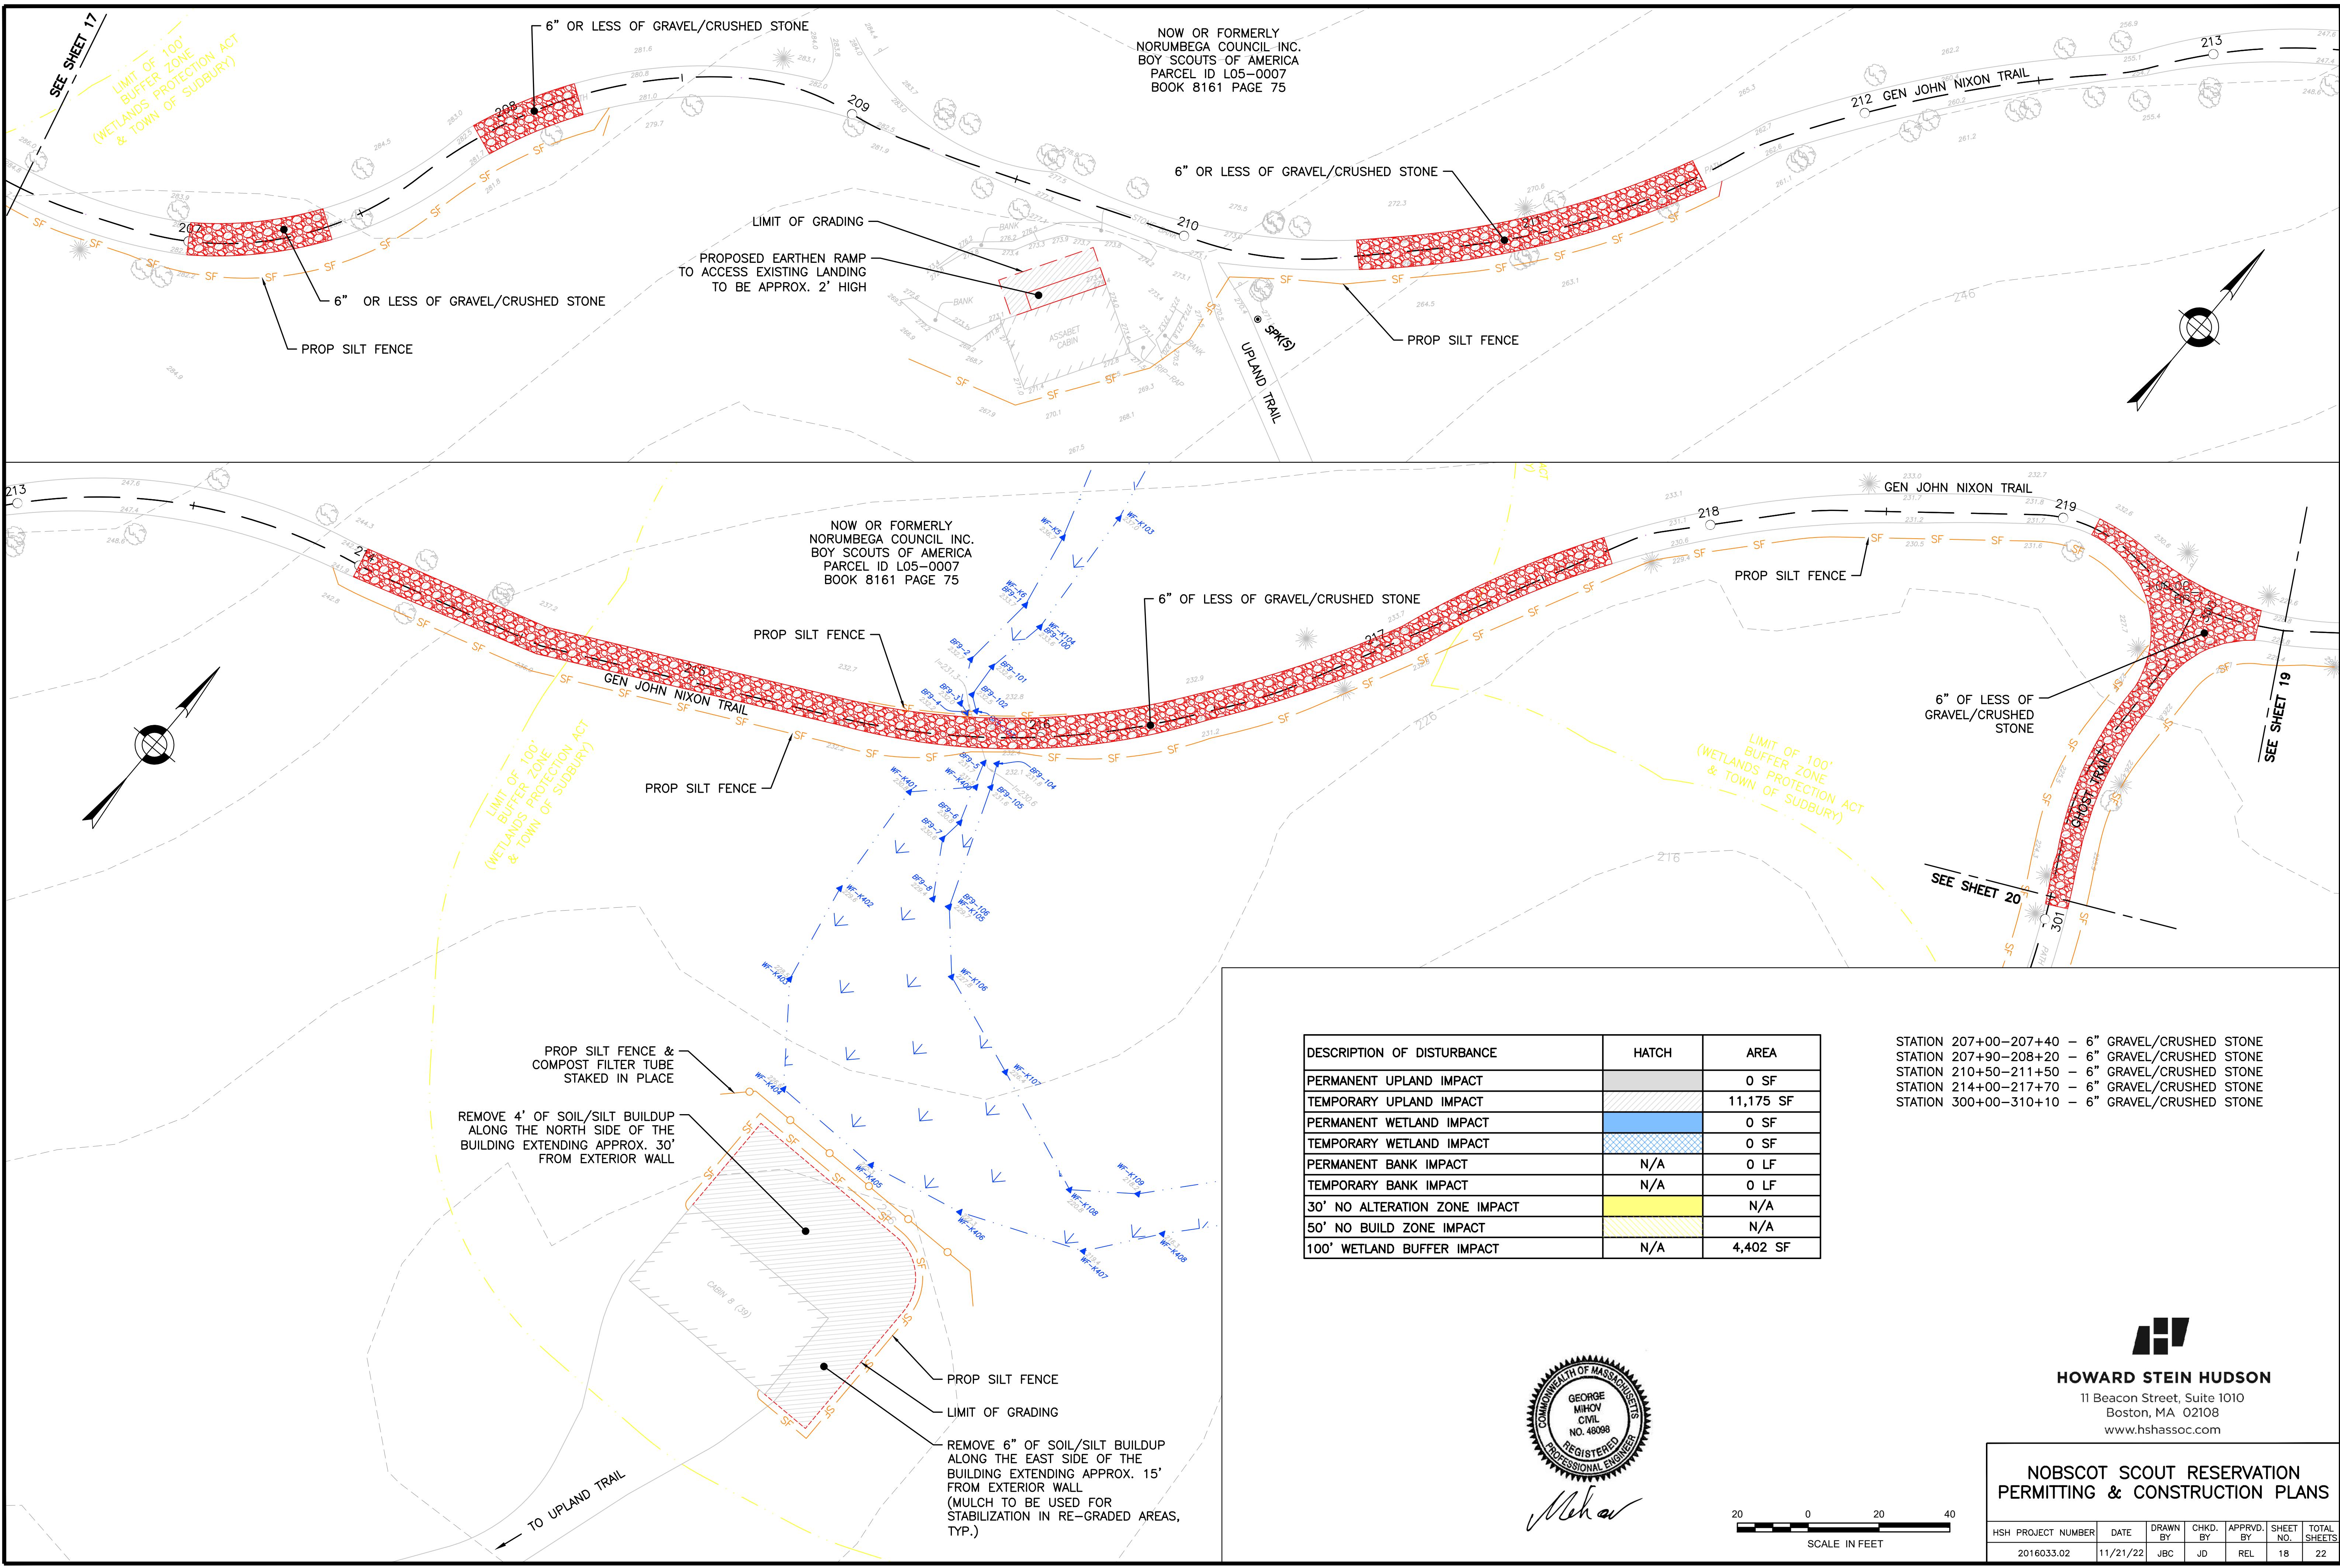

11/21/2022 L:\16033\CURRENT\CUTSHEETS\16033 NOI PLANS.dwg
Joseph Connolly

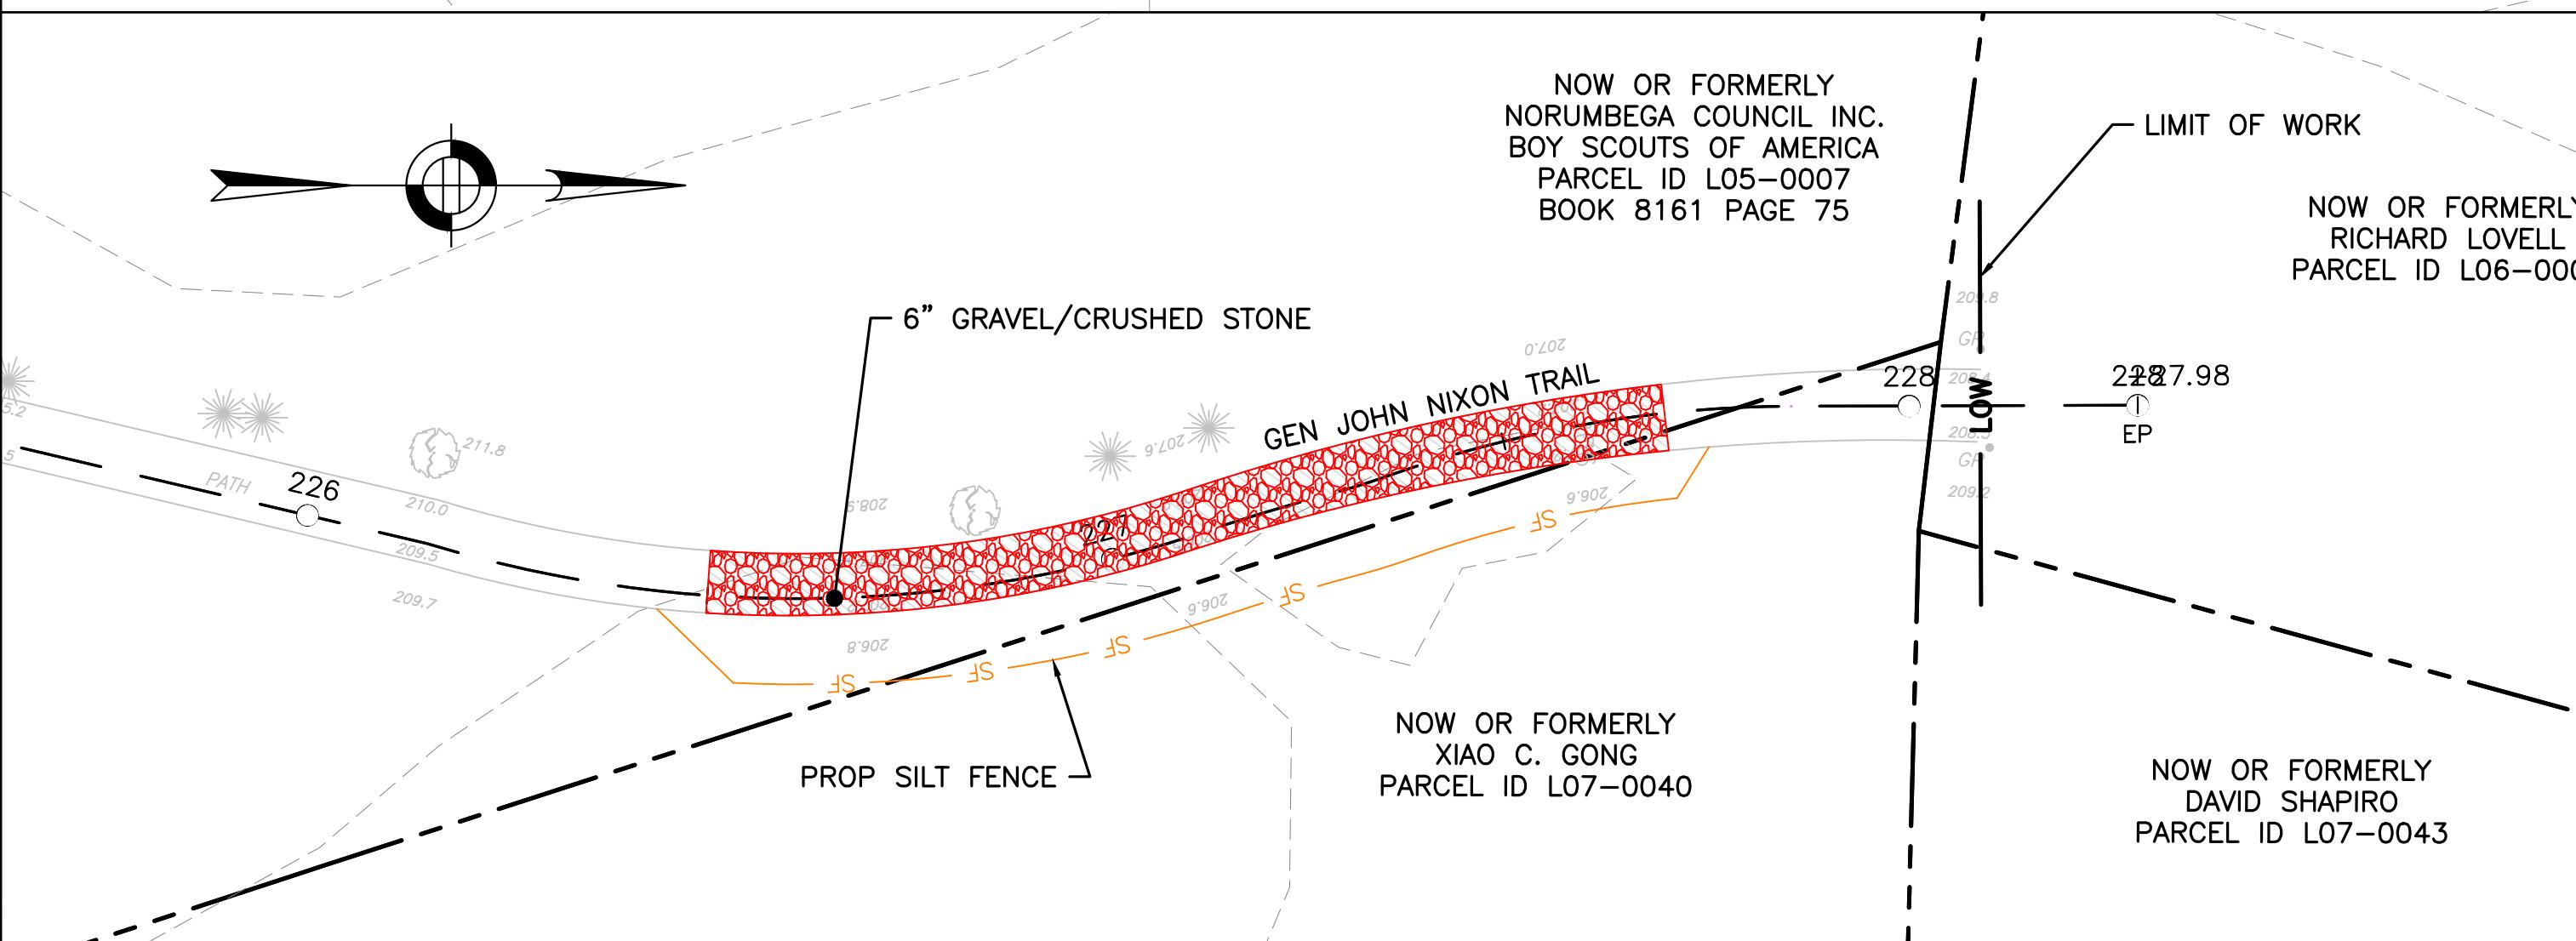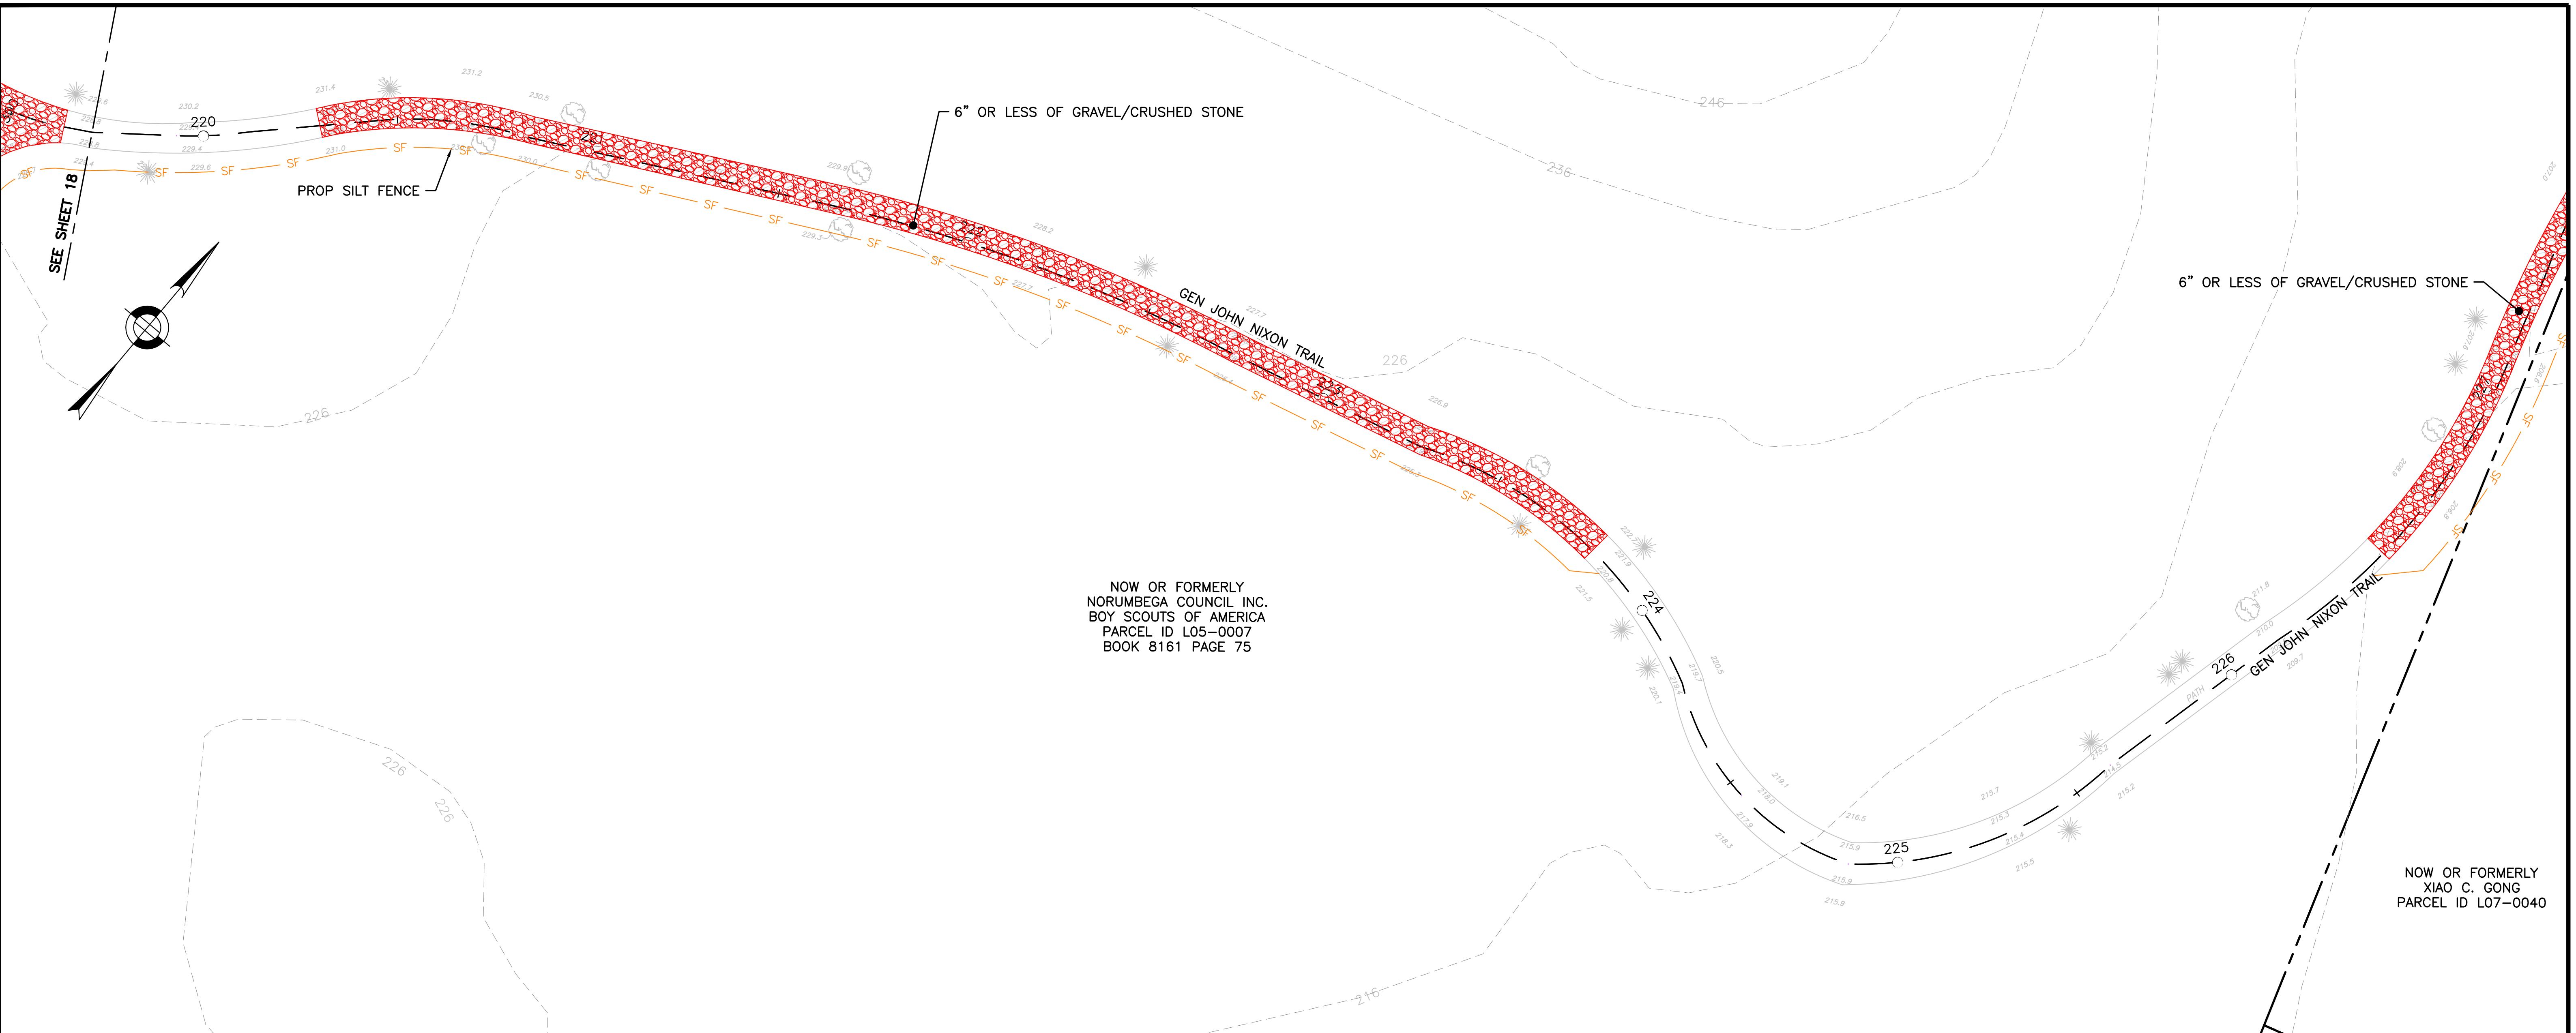

DESCRIPTION OF DISTURBANCE	HATCH	AREA
PERMANENT UPLAND IMPACT		0 SF
TEMPORARY UPLAND IMPACT		3,513 SF
PERMANENT WETLAND IMPACT		0 SF
TEMPORARY WETLAND IMPACT		0 SF
PERMANENT BANK IMPACT	N/A	0 LF
TEMPORARY BANK IMPACT	N/A	0 LF
30' NO ALTERATION ZONE IMPACT		N/A
50' NO BUILD ZONE IMPACT		N/A
100' WETLAND BUFFER IMPACT	N/A	0 SF



Mehan


20 0 20 40
SCALE IN FEET


HOWARD STEIN HUDSON

11 Beacon Street, Suite 1010
Boston, MA 02108
www.hshassoc.com

**NOBSCOT SCOUT RESERVATION
PERMITTING & CONSTRUCTION PLANS**

HSH PROJECT NUMBER	DATE	DRAWN BY	CHKD. BY	APPRVD. BY	REL	Sheet No.	Total Sheets
2016033.02	11/21/22	JBC	JD		19	22	

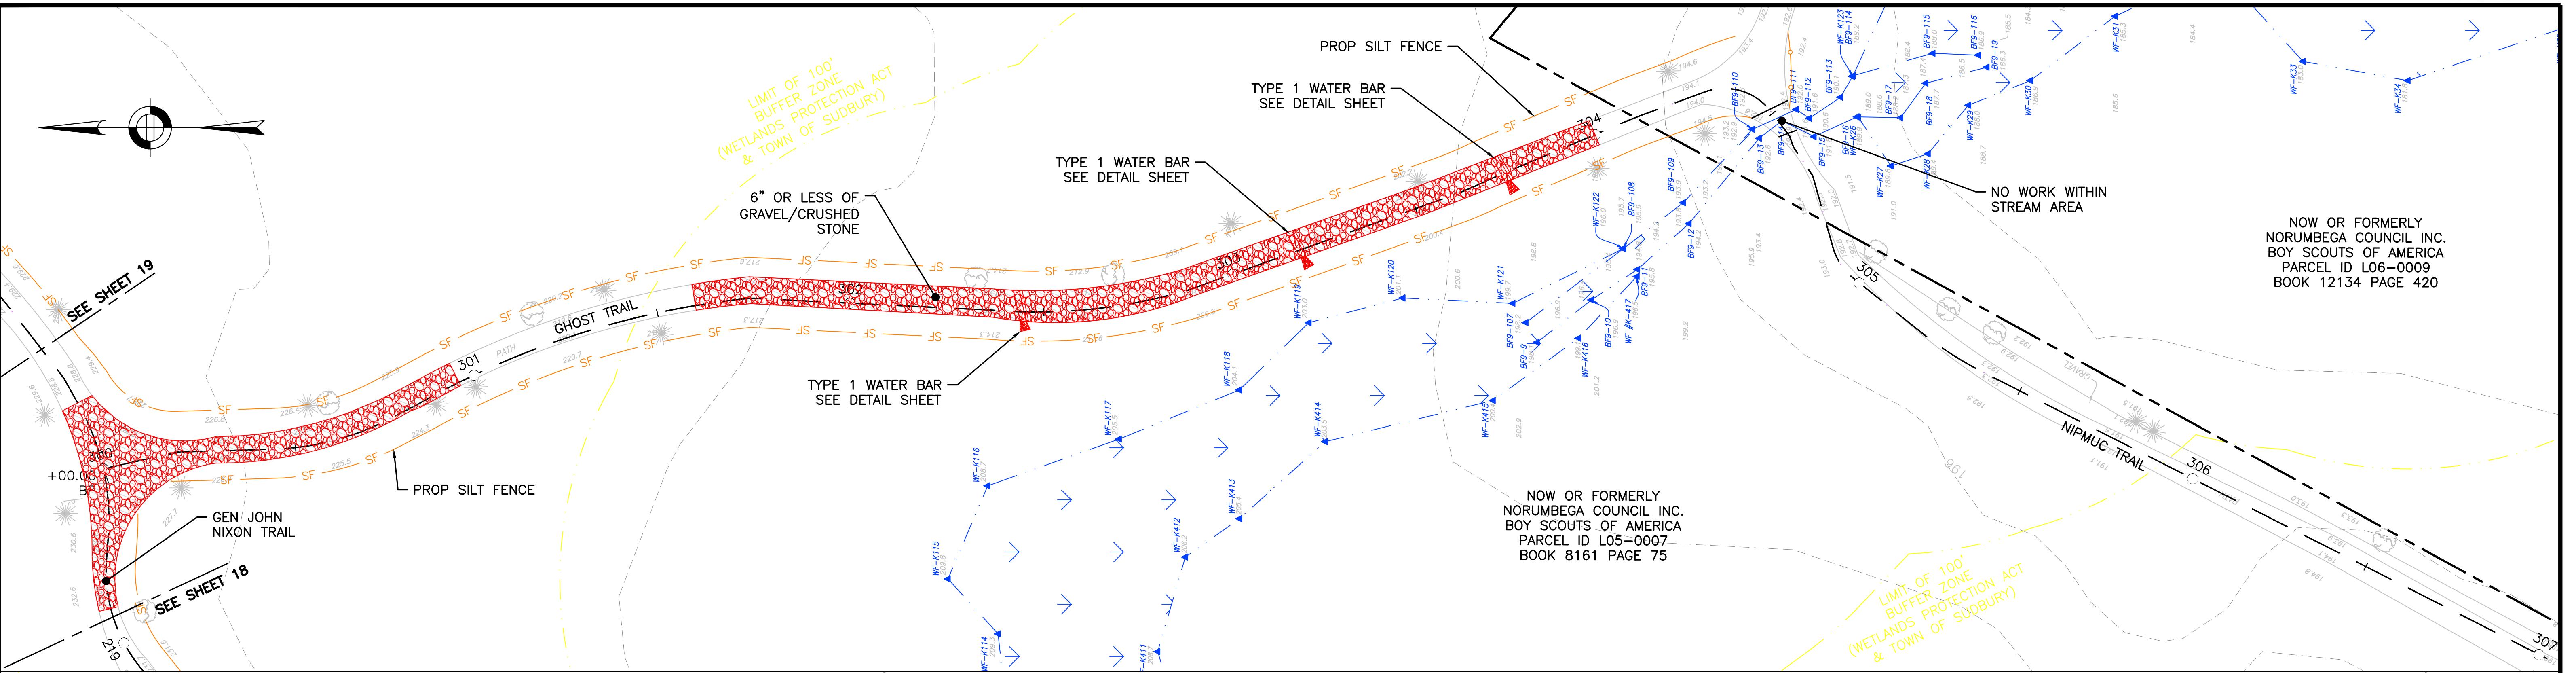


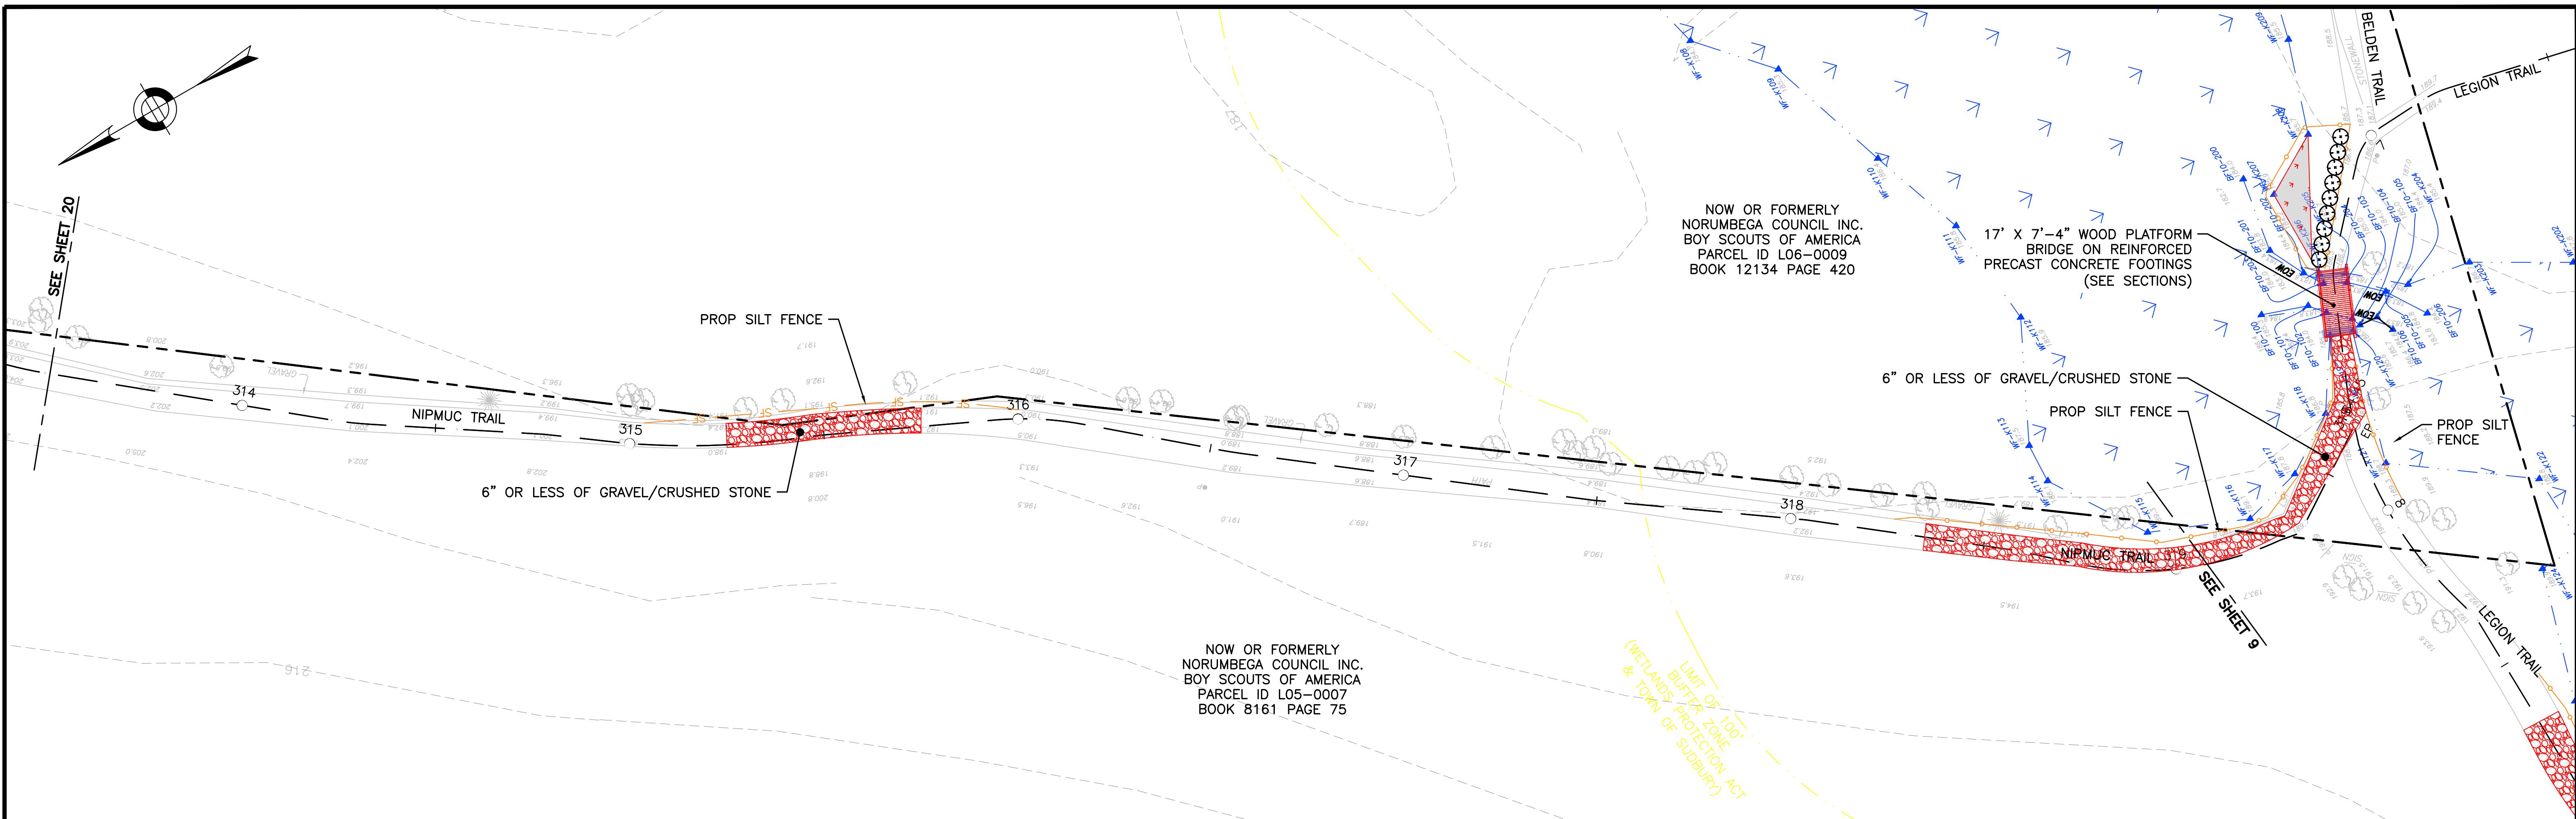


STATION 7+53-7+78 - 6" GRAVEL/CRUSHED STONE
STATION 315+25-315+75 - 6" GRAVEL/CRUSHED STONE
STATION 318+25-319+65 - 6" GRAVEL CRUSHED STONE

DESCRIPTION OF DISTURBANCE	HATCH	AREA
PERMANENT UPLAND IMPACT		0 SF
TEMPORARY UPLAND IMPACT	/	786 SF
PERMANENT WETLAND IMPACT	█	0 SF
TEMPORARY WETLAND IMPACT	◆	34 SF
PERMANENT BANK IMPACT	N/A	0 LF
TEMPORARY BANK IMPACT	N/A	16 LF
30' NO ALTERATION ZONE IMPACT	█	N/A SF
50' NO BUILD ZONE IMPACT	/	N/A
100' WETLAND BUFFER IMPACT	N/A	470 SF



HOWARD STEIN HUDSON
11 Beacon Street, Suite 1010
Boston, MA 02108
www.hsbassoc.com

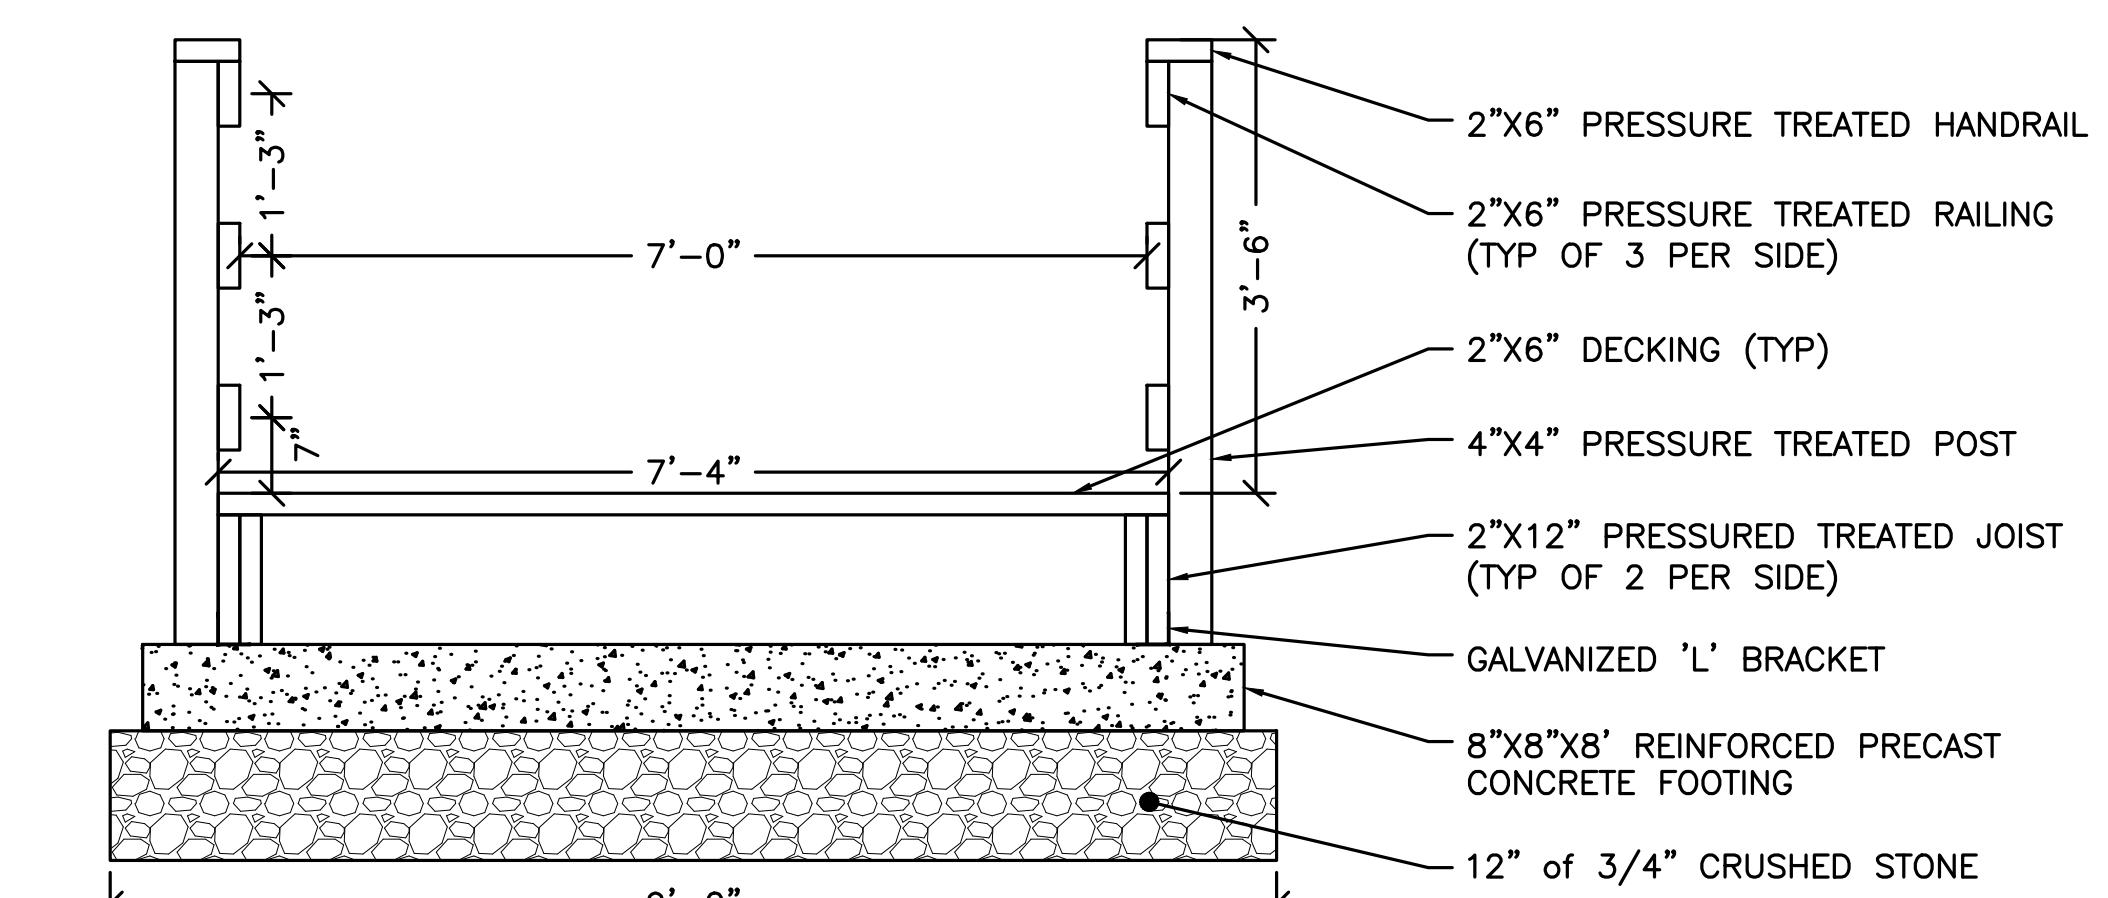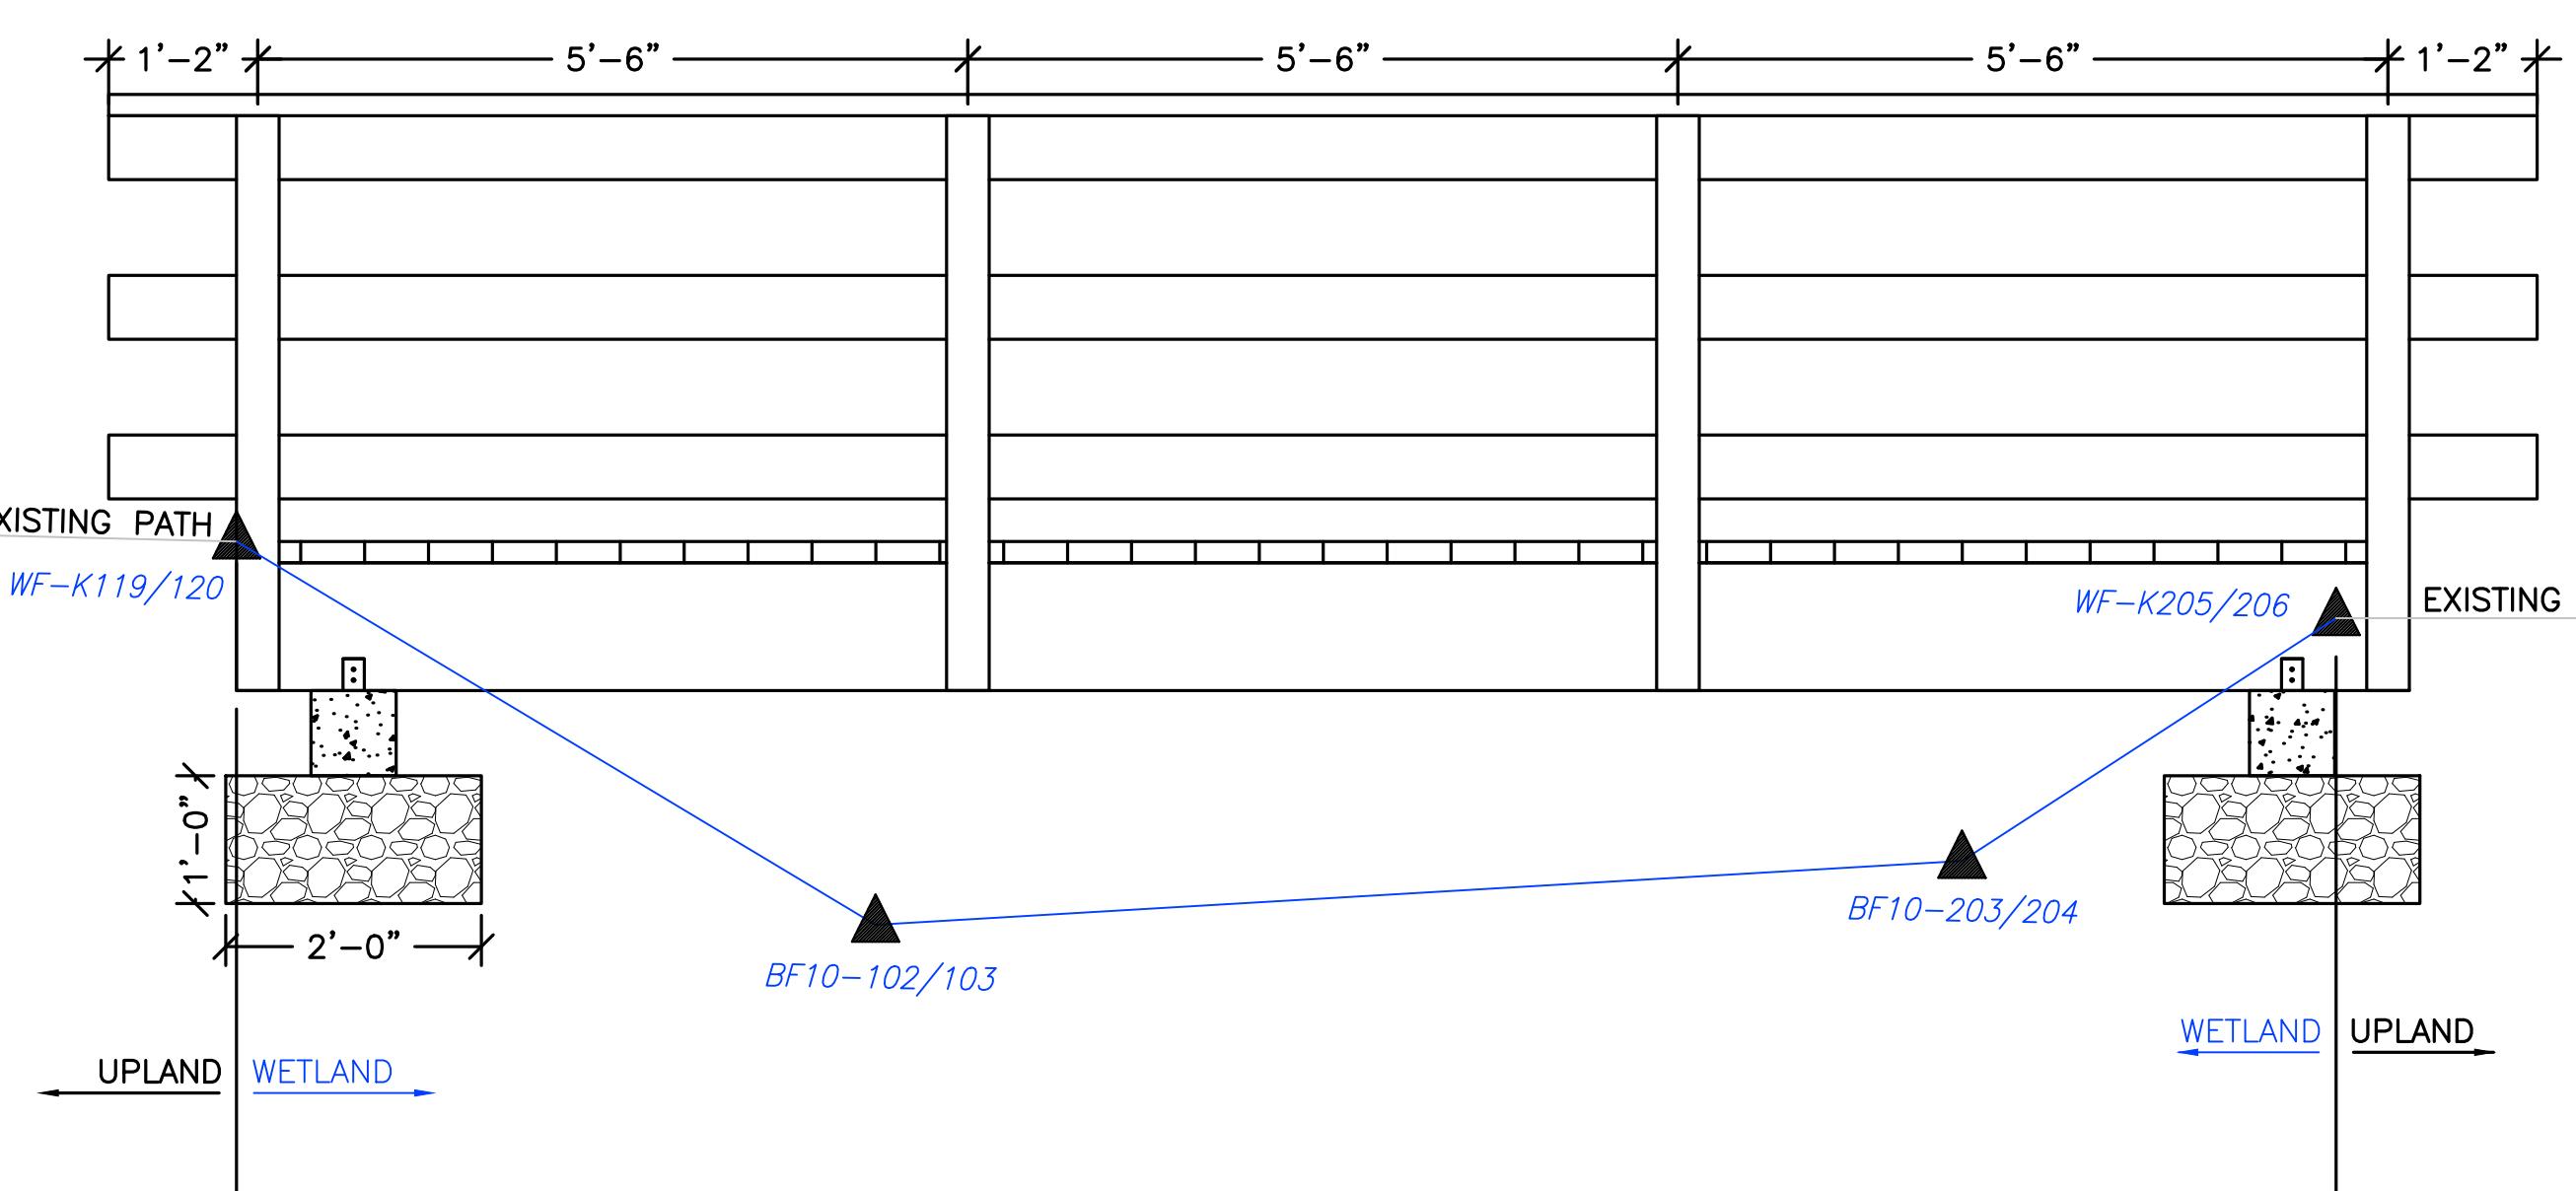

BELDEN BRIDGE SECTION
NOT TO SCALE



NOBSCOT SCOUT RESERVATION PERMITTING & CONSTRUCTION PLANS


HSH PROJECT NUMBER	DATE	DRAWN BY	CHKD. BY	APPRVD. BY	SHEET NO.	TOTAL SHEETS
2016033.02	11/21/22	JBC	JD	REL	21	22



HOWARD STEIN HUDSON
11 Beacon Street, Suite 1010
Boston, MA 02108
www.hshassoc.com

PREPARED FOR:
KNOX TRAIL COUNCIL
BOY SCOUTS OF AMERICA
490 UNION AVENUE
FRAMINGHAM, MA 01702

NOBSCOT SCOUT RESERVATION TRAIL PROJECT FRAMINGHAM AND SUDSBURY, MA WORCESTER COUNTY

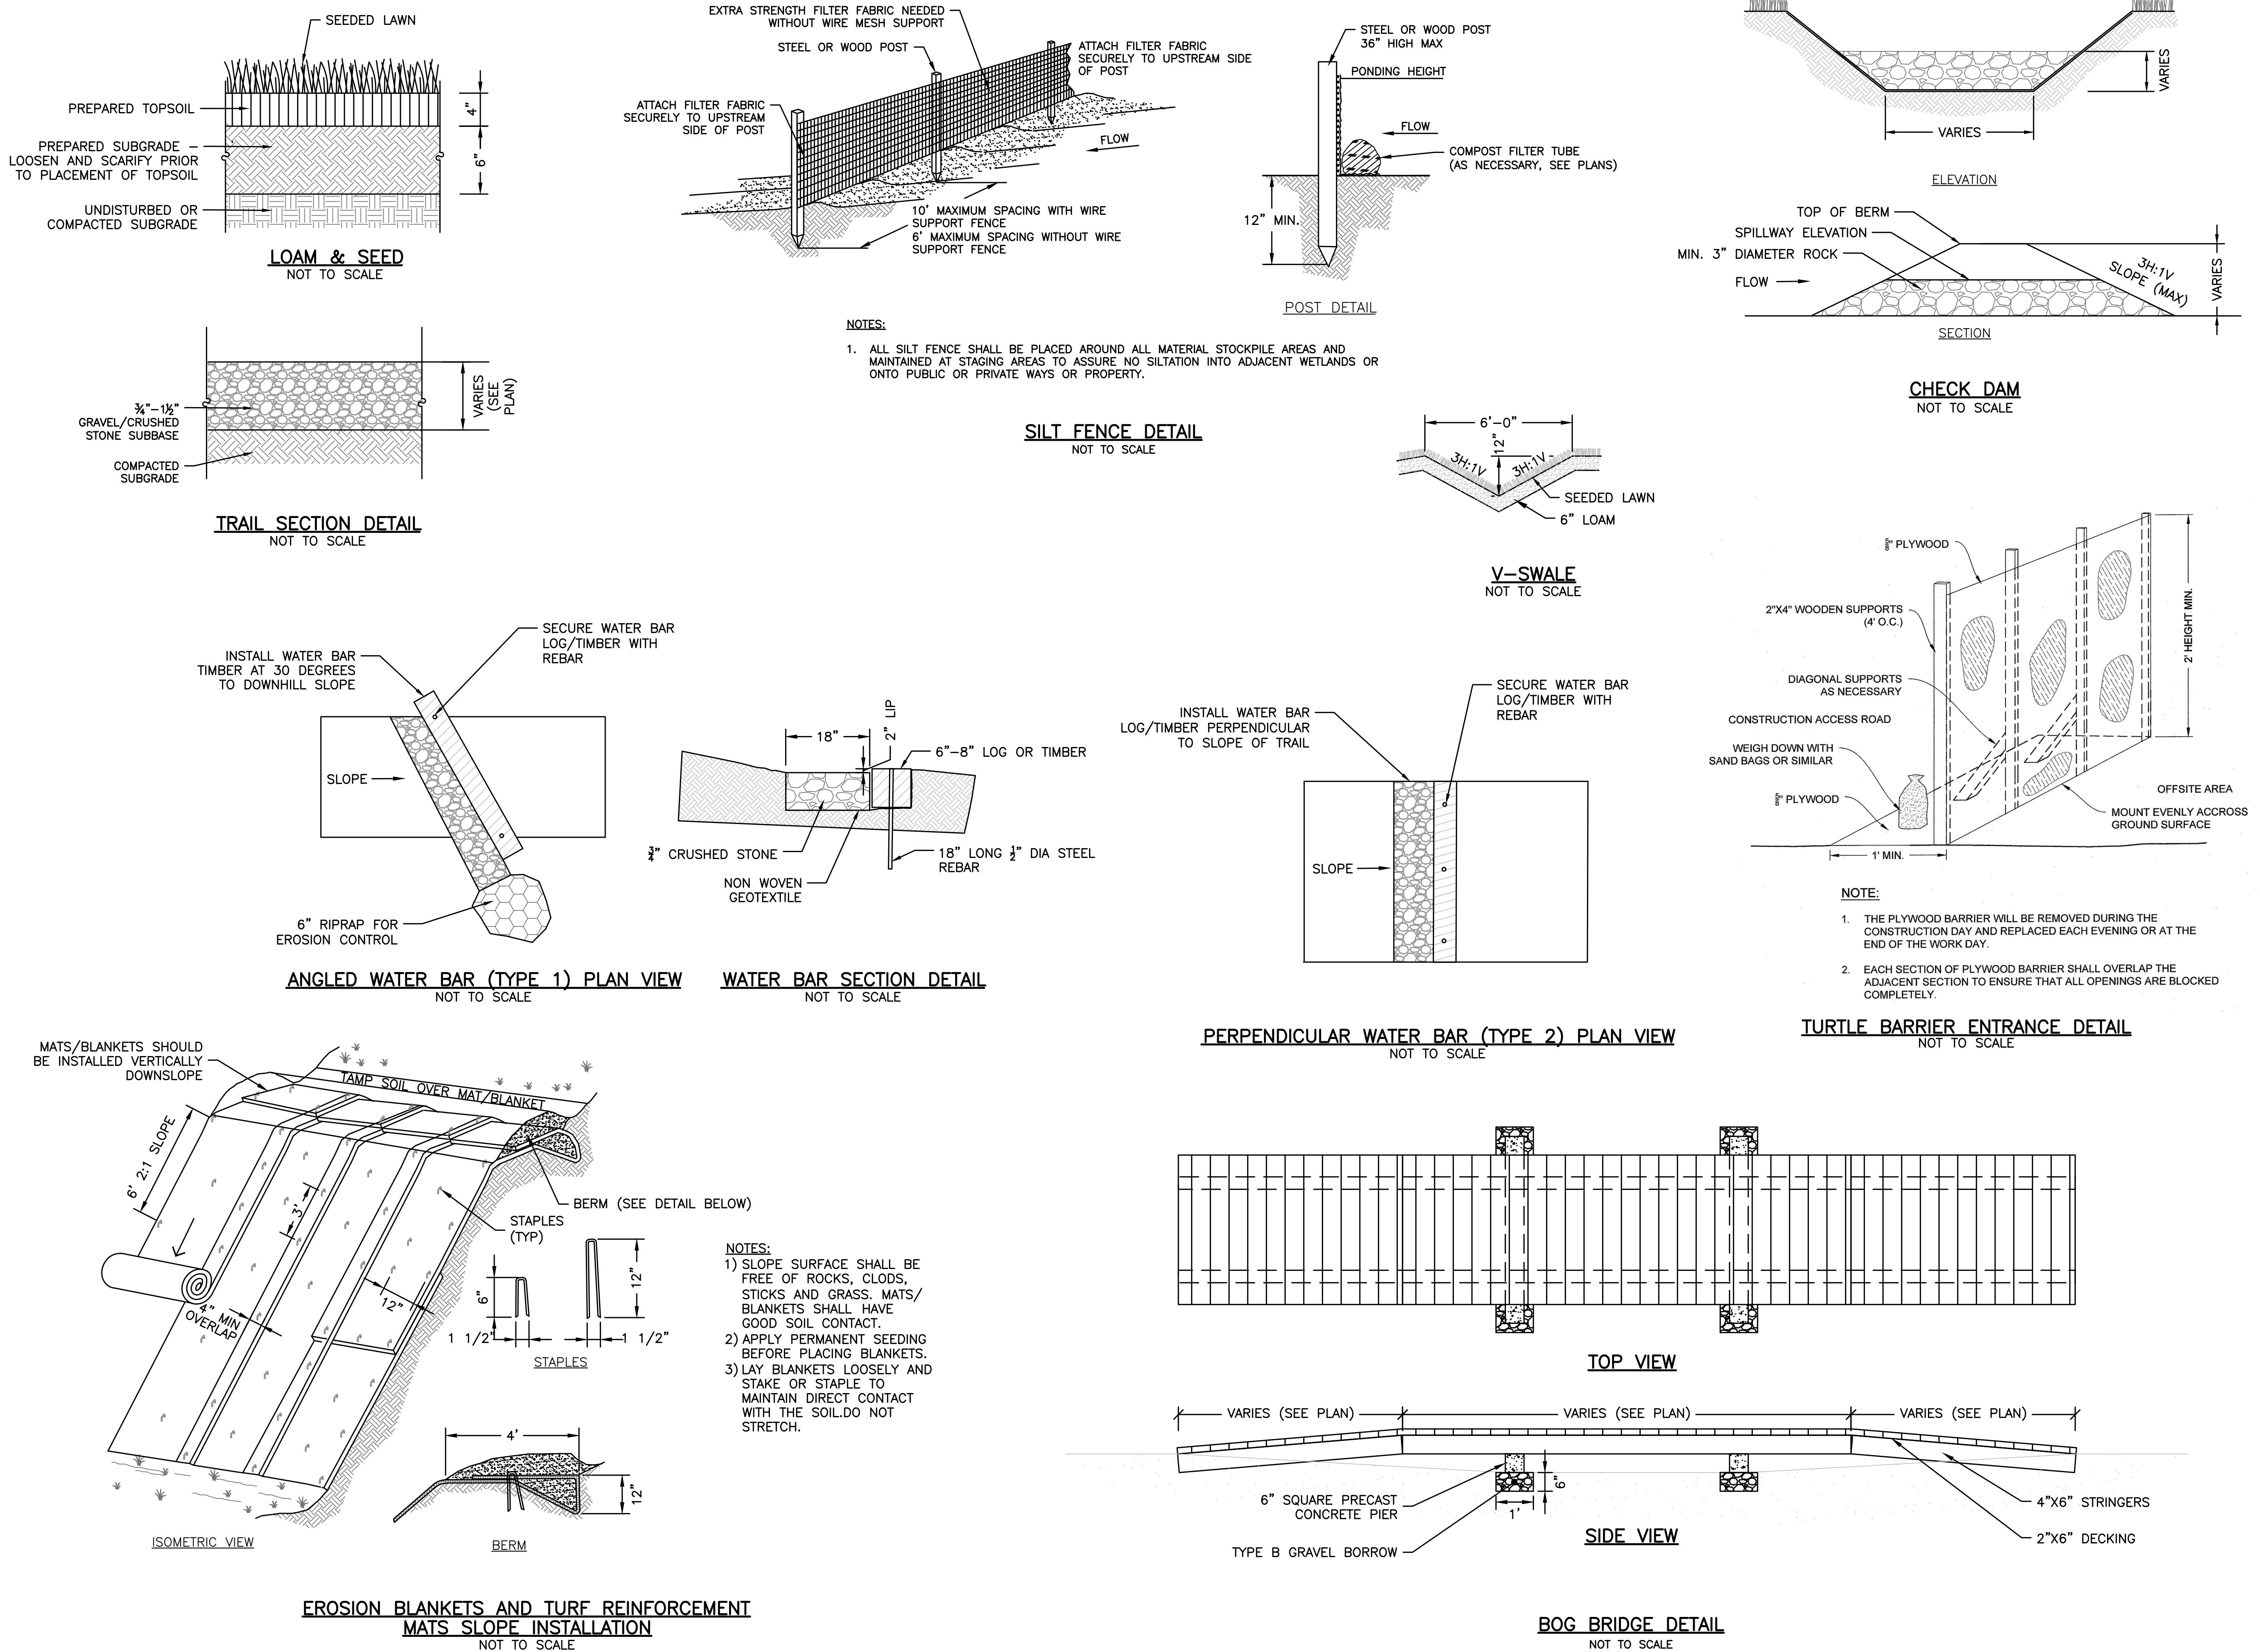

NOTICE OF INTENT
PERMIT SET

DETAILS

DATE:	11/21/2022
PROJECT NUMBER:	16033.02
DESIGNED BY:	JBC
DRAWN BY:	JBC
CHECKED BY:	REL